

HVAC SPECIFICATIONS	
1.	A MAINTENANCE LABEL SHALL BE AFFIXED TO MECHANICAL EQUIPMENT AND A MAINTENANCE MANUAL SHALL BE PROVIDED TO THE OWNER PER STANDARDS.
2.	CONCEALED SPACES, CIRCULATION AIR INSULATED WIRES, PLASTIC TUBING OR PIPING, PIPE INSULATION, CONDENSATE PAN INSULATION, WOOD, PVC, ABS AND OTHER PLASTICS) TO BE IN CONCEALED SPACES USED TO CONVEY CIRCULATING AIR SUPPLY. WHEN COMBUSTIBLE MATERIAL IS TO BE LOCATED IN THE ABOVE SPACES, IT SHALL BE APPROVED FOR SUCH INSULATION.
3.	INSULATION OF DUCTS PORTIONS OF SUPPLY-AIR AND RETURN-AIR DUCTS CONVEYING HEATED OR COOLED AIR LOCATED IN ONE OR MORE OF THE FOLLOWING SPACES SHALL BE INSULATED TO A MINIMUM INSTALLED LEVEL OF R-8: 1. OUTDOORS; OR 2. IN A SPACE BETWEEN THE ROOF AND AN INSULATED CEILING; OR 3. IN A SPACE DIRECTLY UNDER A ROOF WITH FIXED VENTS OR OPENINGS TO THE OUTSIDE OR UNCONDITIONED SPACES; OR 4. IN AN UNCONDITIONED CRAWL SPACE; OR 5. IN OTHER UNCONDITIONED SPACES. PORTIONS OF SUPPLY-AIR DUCTS THAT ARE NOT IN ONE OF THESE SPACES, INCLUDING DUCTS BURIED IN CONCRETE SLAB, SHALL BE INSULATED TO A MINIMUM INSTALLED LEVEL OF R-4.2 OR BE ENCLOSED IN DIRECTLY CONDITIONED SPACE.
4.	SEALING TRANSVERSE SUPPLY DUCTS, TAPED OR SEALED WITH MASTIC EXCEPT FOR DUCTS EXPOSED TO CONDITIONED SPACE, WHERE DUCT STATIC PRESSURE EXCEEDS 3/4" WATER, LONGITUDINAL JOINTS, TAPED OR SEALED WITH MASTIC.
5.	INSPECTION INSPECTION TO BE MADE AND DUCTWORK APPROVED BEFORE COVERING WITH INSULATION.
6.	PIPE INSULATION SPACE-CONDITIONING AND SERVICE WATER-HEATING SYSTEM SHALL BE INSULATED IN ACCORDANCE WITH THE FOLLOWING TABLE:

PIPE INSULATION THICKNESS									
FLUID TEMP. RANGE (°F)	CONDUCTIVITY RANGE (BTU·IN/HR PER SQ·FT·F)	INSULATION MEAN RATING TEMP. (°F)	NOMINAL PIPE DIAMETER (")						
			<1	1 TO <1.5	1.5 TO 4	4 TO 8	8 AND LARGER		
			INSULATION THICKNESS REQUIRED (")						
SPACE HEATING, HOT WATER SYSTEMS AND SERVICE WATER HEATING SYSTEMS									
350+	0.32-0.34	250	4.5	5.0	5.0	5.0	5.0		
251-350	0.29-0.31	200	3.0	4.0	4.5	4.5	4.5		
201-250	0.27-0.30	150	2.5	2.5	2.5	3.0	3.0		
141-200	0.25-0.29	125	1.5	1.5	2.0	2.0	2.0		
105-140	0.22-0.28	100	1.0	1.5	1.5	1.5	1.5		
SPACE COOLING SYSTEMS (CHILLED WATER, REFRIGERANT AND BRINE)									
40-60	0.21-0.27	75	NONRES 0.5	NONRES 0.75	NONRES 0.75	1.0	1.0	1.0	
<40	0.20-0.26	50	1.0	1.5	1.5	1.5	1.5	1.5	

EXCEPTIONS: THE FOLLOWING PIPING DOES NOT HAVE TO BE THERMALLY INSULATED: (1) FACTORY-INSTALLED PIPING WITHIN SPACE CONDITIONING EQUIPMENT; (2) PIPING THAT CONVEYS FLUIDS THAT HAVE A DESIGN OPERATING TEMPERATURE RANGE BETWEEN 55 DEGREES AND 105 DEGREES FAHRENHEIT; (3) GAS PIPING; (4) COLD DOMESTIC WATER PIPING; (5) DRAINS, VENTS, AND WASTE PIPING.

7.	TEMPERATURE CONTROLS EACH HVAC SYSTEM SHALL BE PROVIDED WITH AT LEAST ONE AUTOMATIC TEMPERATURE CONTROL DEVICE FOR THE REGULATION OF TEMPERATURE. THESE AUTOMATIC TEMPERATURE CONTROL DEVICES SHALL BE CAPABLE OF BEING SET TO MAINTAIN SPACE TEMPERATURE SET POINTS FROM 55 DEGREES F TO 85 DEGREES F, SHALL BE CAPABLE OF OPERATING THE SYSTEM HEATING AND/OR COOLING IN SEQUENCE.
----	---------------------------------------------------------------------------------------------------------------------------------------------------------------------------------------------------------------------------------------------------------------------------------------------------------------------------------------------------------------------------------------------

EXCEPT AS ALLOWED, THESE CONTROLS SHALL BE ADJUSTABLE TO PROVIDE A DEAD BAND OF 5 DEGREES F BETWEEN FULL HEATING AND FULL COOLING. CONTROLS SHALL HAVE THE CAPABILITY OF TERMINATING ALL HEATING AT A TEMPERATURE NO MORE THAN 70 DEGREES F AND OF TERMINATING ALL COOLING AT A TEMPERATURE NOT LESS THAN 78 DEGREES F.

SHEET INDEX	
M000	MECHANICAL NOTES
M001	MECHANICAL SCHEDULES
M002	MECHANICAL DETAILS
M100	MECHANICAL PLAN - 1ST FLOOR
M101	MECHANICAL PLAN - 2ND FLOOR
M102	MECHANICAL PLAN - ROOF
TM00	TITLE 24
TM01	TITLE 24
TM02	TITLE 24

SCOPE OF WORK	
• OFFICE - WAREHOUSE EXPANSION.	
• PROVIDE THREE(4) NEW ROOFTOP UNITS FOR EAST WING.	
• PROVIDE GRAVITY VENTILATORS FOR WEST WING.	
• PROVIDE DUCTWORKS AND AIR DEVICES THROUGHOUT THE EAST WING.	

MECHANICAL CODE	
• 2019 CMC	
• 2019 BUILDING ENERGY EFFICIENCY STANDARDS	

SYMBOLS AND ABBREVIATIONS		
SA		SUPPLY AIR PLENUM CROSS-SECTION
RA		RETURN AIR PLENUM CROSS-SECTION
CD		SUPPLY DIFFUSER
RAG		RETURN AIR GRILLE
EAG		EXHAUST AIR GRILLE
SWS		SIDE WALL SUPPLY REGISTER
SWR		SIDE WALL RETURN GRILLE
CFM		ROOM THERMOSTAT
EA		ROOM SENSOR
EF		CUBIC FEET PER MINUTE
EX		EXHAUST AIR
ESP		ROOF MOUNTED EXHAUST FAN
EXIST		EXTERNAL STATIC PRESSURE
FD		EXISTING
FLA		FIRE DAMPER
HZ		FULL LOAD AMPERES
HP		HERTZ
MVD		HORSEPOWER
NEW		MANUAL VOLUME DAMPER
OSA		NEW
RLA		OUTSIDE SUPPLY AIR
RA		RATED LOAD AMPERES
SA		RETURN AIR
SD		SMOKE DETECTOR
SP		STATIC PRESSURE
TYP		TYPICAL
U/C		UNDERCUT DOOR
U.T.R.		UP THRU ROOF
V		VOLT
VTR		VENT THRU ROOF
CO2		CO2 SENSOR
MECH		MECHANICAL EQUIPMENT TAG
POC		POC
NEW DUCT		NEW DUCT
EXISTING DUCT		EXISTING DUCT
CD		CONDENSATE DRAIN

DUCT GAUGE SELECTIONS			
FOR GALVANIZED STEEL (SMACNA TABLE 1-4(E))			
MAXIMUM 1" W.G. STATIC POSITIVE AND NEGATIVE			
DUCT DIAMETER (INCHES)	MINIMUM THICKNESS GALVANIZED IRON (U.S. GAUGE/INCHES)	MINIMUM THICKNESS ALUMINUM (INCHES)	
LESS THAN 12	26/ 022	.025	
13-30	26/ 022	.025	
31-36	24/ 023	.026	
FOOTNOTES:			
1. HEATING AND AIR CONDITIONING UNITS NOT EXCEEDING 2000 CFM OR ONE INCH WATER GAUGE (WG) POSITIVE OR NEGATIVE PRESSURE. DUCT FITTINGS SHALL BE CONSTRUCTED OF MATERIAL NOT LESS THAN THE GAUGE OF THE DUCT.			
2. DUCTWORK AND FITTINGS LARGER THAN TWENTY INCHES SHALL BE CONSTRUCTED TO THE GAUGING REQUIREMENTS OF ANSI SMACNA 006-2006 HVAC DUCT CONSTRUCTION STANDARDS.			

HVAC GENERAL NOTES	
1.	ALL WORK SHALL CONFORM TO MECHANICAL CODE, BUILDING CODE AND ALL OTHER APPLICABLE CITY CODES AND REGULATIONS.
2.	THE CONTRACTOR SHALL PAY FOR ALL PERMITS AND FEES.
3.	CONTROL LOW VOLTAGE WIRING BY MECHANICAL CONTRACTOR AND CONDUIT BY ELECTRICAL CONTRACTOR.
4.	CONDENSATE DRAIN PIPING AND FINAL CONNECTION TO UNIT BY PLUMBING CONTRACTOR.
5.	G.C. TO VERIFY CURRENT ELECTRICAL POWER CONDITION IN FIELD BEFORE PURCHASING ANY MECHANICAL EQUIPMENT.
6.	CONTRACTOR TO VERIFY MECHANICAL HEATING EQUIPMENT TO BE CONFORM TO LOCAL EPA STANDARD BEFORE PURCHASING EQUIPMENT.
7.	ACCURATE AS-BUILT DRAWINGS SHALL BE MADE DURING CONSTRUCTION AND SUBMITTED FOR APPROVAL UPON COMPLETION OF INSTALLATION.
8.	THE CONTRACTOR SHALL COORDINATE WITH GENERAL CONTRACTOR FOR SIZE AND LOCATION OF DUCTWORK ROOF OPENINGS AND WITH ELECTRICAL CONTRACTOR FOR ELECTRICAL REQUIREMENTS OF ALL MECHANICAL EQUIPMENT AND ARCHITECTURAL DRAWINGS FOR AIR DISTRIBUTION LOCATION.
9.	THE CONTRACTOR SHALL SUBMIT BID BASED ON THE DRAWINGS AND ALTERNATE FOR COST SAVING. THESE DRAWINGS ARE FOR BIDDING PURPOSES.
10.	THE CONTRACTOR SHALL FURNISH ALL MATERIALS, LABOR, EQUIPMENT, TRANSPORTATION AND SERVICES NECESSARY FOR COMPLETION OF THE WORK. ALL MATERIALS AND WORK SHALL COMPLY WITH APPLICABLE CODES AND GOVERNING REGULATIONS AND MEET THE APPROVAL OF THE LOCAL JURISDICTION.
11.	TAKE ALL PRECAUTIONS NECESSARY TO PROTECT THE MATERIALS BEFORE, DURING AND AFTER INSTALLATION. IN THE EVENT OF DAMAGE, IMMEDIATELY REPAIR ALL DAMAGED AND DEFECTIVE WORK TO THE APPROVAL OF THE ARCHITECT AT NO ADDITIONAL COST TO THE OWNER.
12.	THESE DRAWINGS ARE DIAGRAMMATIC. THE CONTRACTOR SHALL BE RESPONSIBLE FOR COORDINATING HIS WORK WITH ALL OTHER TRADES. THIS INCLUDES COORDINATING THE LOCATION AND SIZE OF ALL OPENINGS, LOCATIONS OF EQUIPMENT PADS AND CHANGES OF ELEVATIONS OF DUCTWORK, PIPING AND OTHER EQUIPMENT.
13.	ANY MATERIAL, ARTICLE OR PIECE OF EQUIPMENT OTHER THAN THAT INDICATED SHALL NOT BE USED UNLESS APPROVED IN WRITING BY THE ENGINEER AND ANY CHANGES IN MECHANICAL, ELECTRICAL AND/OR OTHER SYSTEMS REQUIRED DUE TO SUCH SUBSTITUTION SHALL BE THE RESPONSIBILITY OF THE HVAC CONTRACTOR; AND AT NO ADDITIONAL COST TO THE OWNER.
14.	THE CONTRACTOR SHALL VISIT SITE PRIOR TO BIDDING TO VERIFY LOCATIONS AND SIZES OF ALL EXISTING EQUIPMENT AND INFORM THE ARCHITECT AND ENGINEER OF ANY DISCREPANCIES.
15.	COORDINATE ENTIRE INSTALLATION OF THE H.V.A.C. SYSTEM WITH THE WORK OF ALL OTHER TRADES PRIOR TO ANY FABRICATION OR INSTALLATION. PROVIDE ALL FITTINGS, OFFSETS, AND TRANSITIONS AS REQUIRED FOR A COMPLETE WORKABLE INSTALLATION.
16.	CONTRACTOR SHALL SUBMIT A COMPLETE BALANCE REPORT FOR APPROVAL. SYSTEMS AIR BALANCE SHALL BE PERFORMED BY AN INDEPENDENT AIR BALANCE CONSULTANT. A CERTIFIED AABC OR NEBB. THE REPORT SHALL INCLUDE THE FOLLOWING: a. AIR QUANTITIES AT EACH REGISTER. b. STATIC PRESSURE READINGS AT INLET AND DISCHARGE OF EACH AIR HANDLING SYSTEM AND AT INLET OF EACH EXHAUST AIR SYSTEM. c. COOLING AND HEATING SUPPLY AND RETURN AIR TEMPERATURES AT EACH AIR CONDITIONING UNIT.
17.	WARRANTIES: 1-YEAR WARRANTY FOR EQUIPMENT, 5-YEAR COMPRESSORS. REFER TO CONSTRUCTION CONTRACT FOR OTHER APPLICABLE WARRANTIES.
18.	EQUIPMENT SPECIFICATION AND INTERLOCK DIAGRAM SHALL BE SUBMITTED FOR APPROVAL PRIOR TO PURCHASE OF EQUIPMENT FOR INSTALLATION.
19.	ALL EQUIPMENT SHALL BE INSTALLED IN STRICT ACCORDANCE WITH THE EQUIPMENT MANUFACTURER'S RECOMMENDATIONS. PROVIDE ALL FITTINGS, TRANSITIONS, DAMPERS, VALVES AND OTHER DEVICES REQUIRED FOR A COMPLETE WORKABLE INSTALLATION.
20.	ALL HVAC AND FAN UNITS SHOWN ON THE PLAN IS RECOMMENDED. FINAL MAKE AND MODEL OF THE UNITS WILL BE DETERMINED BY THE OWNER/MECHANICAL CONTRACTOR WITH AN APPROVAL FROM THE MECHANICAL ENGINEER.
21.	THE HVAC SYSTEM AND COMPONENTS SHALL BE TESTED, ADJUSTED AND BALANCED IN ACCORDANCE WITH AABC'S NATIONAL STANDARDS FOR TOTAL SYSTEM BALANCE (6TH EDITION).
22.	PROVIDE FILTER FOR AIR CONDITIONING AND/OR AIR SIDE UNITS AS REQUIRED PER ASHRAE AND MECHANICAL CODE.
23.	THERMOSTAT SHALL BE 24 VOLT, ONE STAGE HEATING AND ONE OR TWO STAGE COOLING WITH MATCHING SUBBASE AND TAMPER PROOF COVER.
24.	CONDENSATE PIPING SHALL BE SIZED IN ACCORDANCE WITH MECHANICAL CODE.
25.	CONDENSATE WASTE SHALL CONNECT INDIRECTLY TO THE DRAINAGE SYSTEM THROUGH AN AIR GAP OR AIR BREAK TO PROPERLY TRAPPED AND VENTED RECEPTORS, DRY WELLS, OR THE TAILPIECE OF A PLUMBING FIXTURE.
26.	WHERE CONDENSATE WASTE FROM AIR CONDITIONING COILS DISCHARGES BY DIRECT CONNECTION TO A LAVATORY TAILPIECE OR TO AN APPROVED ACCESSIBLE INLET ON A BATHTUB OVERFLOW, THE CONNECTION SHALL BE LOCATED IN AN AREA CONTROLLED BY THE SAME PERSON CONTROLLING THE AIR-CONDITIONED SPACE.
27.	THE REFRIGERATION EQUIPMENT REFRIGERANT SERVICE PORTS LOCATED OUTDOORS SHALL BE FITTED WITH LOCKING TYPE TAMPER RESISTANT CAPS OR SHALL BE PROTECTED FROM UNAUTHORIZED ACCESS BY A MEANS ACCEPTABLE TO THE ENFORCING AGENCY.
28.	THE HEATING AND COOLING DUCT SYSTEM IS SIZED IN ACCORDANCE WITH ASHRAE.
29.	G.C. TO VERIFY SUFFICIENCY OF DUCT SPACE BEFORE PURCHASING ANY MECHANICAL EQUIPMENT.
30.	DUCTWORK SHALL BE INSULATED OR LINED AS NOTED ON DRAWINGS. ALL DUCTWORK EXPOSED ON ROOF SHALL BE INTERNALLY LINED UNLESS OTHERWISE INDICATED OR SPECIFIED. ALL DUCT SIZES ARE SHEET METAL SIZES. ALL DUCT JOINTS SHALL BE SEALED PER SPECIFICATIONS.
31.	CONNECT MAIN DUCT TO AIR CONDITIONING UNIT WITH WEATHERPROOF FLEXIBLE CONNECTION. SUN SHIELD OVER ENTIRE FLEXIBLE CONNECTIONS REQUIRED IF FLEXIBLE CONNECTION IS EXPOSED TO WEATHER.
32.	ALL LINED DUCT DIMENSIONS ARE NET CLEAR DIMENSION AFTER LINING HAS BEEN INSTALLED.
33.	ALL DUCTWORK SIZE SHOWN ON PLAN ARE INTERIOR DIAMETER. CONTRACTOR SHALL ADD INSULATION THICKNESS INTO CONSIDERATION BEFORE INSTALLATION.
34.	DUCTS SHALL BE SUPPORTED WITH 1" WIDE 18-GAUGE HANGER STRAPS AND SHALL BE SPACED AT NO MORE THAN 7'-0" ON CENTERS AND SHALL BE SECURED TO STRUCTURAL MEMBER. EXPOSED DUCTWORK ON ROOF SHALL BE SUPPORTED BY GALVANIZED STEEL ANGLE & SHALL BE PER LOCAL CODE.

CA GREEN BUILDING NOTES	
5.504.1	TEMPORARY VENTILATION. IF THE HVAC SYSTEM IS USED DURING CONSTRUCTION, USE RETURN AIR FILTERS WITH A MERV OF 8. BASED ON ASHRAE 52.2-1999, OR AN AVERAGE EFFICIENCY OF 30% BASED ON ASHRAE 52.1-1992. REPLACE ALL FILTERS IMMEDIATELY PRIOR TO OCCUPANCY. APPLIES TO ADDITIONS OR ALTERATIONS.
5.504.3	COVERING OF DUCT OPENINGS AND PROTECTION OF MECHANICAL EQUIPMENT DURING CONSTRUCTION. AT THE TIME OF ROUGH INSTALLATION AND DURING STORAGE ON THE CONSTRUCTION SITE AND UNTIL FINAL STARTUP OF THE HEATING, COOLING AND VENTILATING EQUIPMENT, ALL DUCT AND OTHER RELATED AIR DISTRIBUTION COMPONENT OPENINGS SHALL BE COVERED WITH TAPE, PLASTIC SHEET METAL OR OTHER METHODS ACCEPTABLE TO THE ENFORCING AGENCY TO REDUCE THE AMOUNT OF DUST, WATER AND DEBRIS WHICH MAY ENTER THE SYSTEM.
5.504.5.3	IN MECHANICALLY VENTILATED BUILDINGS, PROVIDE REGULARLY OCCUPIED AREAS OF THE BUILDING WITH AIR FILTRATION MEDIA FOR OUTSIDE AND RETURN AIR PRIOR TO OCCUPANCY THAT PROVIDES AT LEAST A MERV OF 13.
5.506.1	FOR MECHANICALLY OR NATURALLY VENTILATED SPACES IN BUILDINGS, MEET THE MINIMUM REQUIREMENTS OF SECTION 120.1 OF THE CALIFORNIA ENERGY CODE AND CHAPTER 4 OF CCR, TITLE 8, OR THE APPLICABLE LOCAL CODE, WHICHEVER IS MORE STRINGENT.

DEMAND CONTROL VENTILATION NOTES	
2019 BUILDING ENERGY EFFICIENCY STANDARDS SECTION 120.1(D)(4)	
A.	For each system with demand control ventilation (DCV), CO2 sensors shall be installed in each room that meets the criteria of Section 120.1(d)(3) with no less than one sensor per 10,000 ft² of floor space. When a zone or a space is served by more than one sensor, a signal from any sensor indicating that CO2 is near or at the setpoint within the zone or space shall trigger an increase in ventilation.
B.	CO2 sensors shall be located in the room between 3 ft and 6 ft above the floor or at the anticipated height of the occupants' heads.
C.	Demand ventilation controls shall maintain CO2 concentrations less than or equal to 600 ppm plus the outdoor air CO2 concentration in all rooms with CO2 sensors. EXCEPTION to Section 120.1(d)(4C): The outdoor air ventilation rate is not required to be larger than the design outdoor air ventilation rate required by Section 120.1(c)(3) regardless of CO2 concentration.
D.	Outdoor air CO2 concentration shall be determined by one of the following: D.A. CO2 concentration shall be assumed to be 400 ppm without any direct measurement; or D.B. CO2 concentration shall be dynamically measured using a CO2 sensor located within 4 ft of the outdoor air intake.
E.	When the system is operating during hours of expected occupancy, the controls shall maintain system outdoor air ventilation rates no less than the rate listed in Table 120.1-A for DCV, times the conditioned floor area for spaces with CO2 sensors, plus the rate required by Section 120.1(c)(3) for other spaces served by the system, or the exhaust air rate whichever is greater.
F.	CO2 sensors shall be certified by the manufacturer to be accurate within plus or minus 75 ppm at a 600 and 1000 ppm concentration when measured at sea level and 25°C, factory calibrated, and certified by the manufacturer to require calibration no more frequently than once every 5 years. Upon detection of sensor failure, the system shall provide a signal which resets to supply the minimum quantity of outside air to levels required by Section 120.1(c)(3) to the zone served by the sensor at all times that the zone is occupied.
G.	The CO2 sensor(s) reading for each zone shall be displayed continuously, and shall be recorded on systems with DDC to the zone level.

CA TITLE 24 NOTES	
ADMINISTRATIVE REQUIREMENTS:	
A.	THE PERSON WITH OVERALL RESPONSIBILITY FOR CONSTRUCTION OR THE PERSON RESPONSIBLE FOR THE INSTALLATION OF REGULATED FEATURES, MATERIALS, COMPONENTS, OR MANUFACTURED DEVICES SHALL POST OR MAKE AVAILABLE WITH THE BUILDING PERMIT(S) ISSUED FOR THE BUILDING, THE REQUIRED INSTALLATION CERTIFICATE(S) FOR FEATURES, MATERIALS, COMPONENTS, OR MANUFACTURED DEVICES REGULATED BY THE APPLIANCE EFFICIENCY REGULATIONS OR PART 6. SUCH INSTALLATION CERTIFICATE(S) SHALL BE MADE AVAILABLE TO THE ENFORCEMENT AGENCY FOR ALL APPROPRIATE INSPECTIONS. THESE CERTIFICATES SHALL: A.1. IDENTIFY FEATURES, MATERIALS, COMPONENTS, OR MANUFACTURED DEVICES REQUIRED TO VERIFY COMPLIANCE WITH THE APPLIANCE EFFICIENCY REGULATIONS AND PART 6. A.2. INCLUDE A STATEMENT INDICATING THAT THE FEATURES, MATERIALS, COMPONENTS, OR MANUFACTURED DEVICES CONFORM TO THE APPLIANCE EFFICIENCY REGULATIONS AND PART 6 AND THE REQUIREMENTS FOR SUCH FEATURES, MATERIALS, COMPONENTS, OR MANUFACTURED DEVICES GIVEN IN THE PLANS AND SPECIFICATIONS APPROVED BY THE LOCAL ENFORCEMENT AGENCY. A.3. STATE THE NUMBER OF THE BUILDING PERMIT UNDER WHICH THE CONSTRUCTION OR INSTALLATION WAS PERFORMED.
B.	WITHIN 90 DAYS AFTER ISSUANCE OF CERTIFICATE OF OCCUPANCY RECORD DRAWINGS SHALL BE PROVIDED TO THE OWNER. IF A BUILDING DESIGN FEATURE, MATERIAL, COMPONENT OR MANUFACTURED DEVICE IS CHANGED BEFORE FINAL CONSTRUCTION AND INSTALLATION, SUCH THAT THE BUILDING MAY NO LONGER COMPLY WITH PART 6, THE BUILDING MUST BE BROUGHT INTO COMPLIANCE, AND SO INDICATED ON AMENDED PLANS AND CERTIFICATE OF COMPLIANCE(S) THAT SHALL BE SUBMITTED FOR APPROVAL.
C.	THE BUILDER SHALL PROVIDE THE BUILDING OWNER OR THE PERSON(S) RESPONSIBLE FOR BUILDING MAINTENANCE (IN CASE OF MULTI-TENANT OR CENTRALLY OPERATED BUILDINGS) AT OCCUPANCY THE FOLLOWING: C.1. OPERATING INFORMATION: THE APPROPRIATE CERTIFICATE(S) OF COMPLIANCE AND A LIST OF THE FEATURES, MATERIALS, COMPONENTS, AND MECHANICAL DEVICES INSTALLED IN THE BUILDING AND INSTRUCTIONS ON HOW TO OPERATE THEM EFFICIENTLY. C.2. MAINTENANCE INFORMATION: REQUIRED ROUTINE MAINTENANCE ACTIONS SHALL BE CLEARLY STATED AND INCORPORATED ON A READILY ACCESSIBLE LABEL. THE LABEL MAY BE LIMITED TO IDENTIFYING THE OPERATION AND MAINTENANCE MANUAL. C.3. VENTILATION INFORMATION: A DESCRIPTION OF THE QUANTITIES OF OUTDOOR AND RECIRCULATED AIR THAT THE VENTILATION SYSTEMS ARE DESIGNED TO PROVIDE TO EACH AREA.
36.	ROUND AND RECTANGULAR DUCTWORK ARE INTERCHANGEABLE IF CROSS SECTION AREAS ARE EQUIVALENT. CONTRACTOR IS TO VERIFY THAT EXACT CEILING SPACE AND INTERCHANGE THE DUCT SIZE TO FIT THE CEILING SPACE WITHOUT ADDITIONAL FEE CHARGE.
37.	ALL FACTORY-FABRICATED DUCT SYSTEMS SHALL COMPLY WITH UL 181 FOR DUCTS AND CLOSURE SYSTEMS, INCLUDING COLLARS, CONNECTIONS, AND SPLICES, AND BE LABELED AS COMPLYING WITH UL 181.
38.	INSTALL VOLUME CONTROL DAMPERS AT EACH SUPPLY DIFFUSER TO AFFORD COMPLETE CONTROL OF THE AIR FLOW IN THE EXHAUST DUCT SYSTEMS. INSTALL SPLITTER DAMPER AT DUCT TAKEOFFS AND DAMPER AS REQUIRED.
39.	AUTOMATIC FIRE DAMPER REQUIREMENTS ARE AS FOLLOWS: a. PROVIDE AUTOMATIC FIRE DAMPERS AT ALL PENETRATIONS OF FIRE-RATED CEILINGS AND WALLS THROUGHOUT. CONTRACTOR SHALL COORDINATE WITH FIRE-RATED CEILING AREAS AND WALLS AS INDICATED ON ARCHITECTURAL DRAWINGS. THIS NOTE SHALL TAKE PRECEDENCE OVER ANY OMISSIONS ON THE DRAWINGS. SEE SPECIFICATIONS. b. LOCATION OF FIRE-RATED CEILINGS AND WALLS ARE AS INDICATED ON THE ARCHITECTURAL DRAWINGS.
40.	COORDINATE THE LOCATION OF ALL CEILING DIFFUSERS, REGISTERS AND GRILLES WITH THE ARCHITECTURAL REFLECTED CEILING PLAN, ELECTRICAL LIGHTING LAYOUT AND ARCHITECTURAL ROOM ELEVATIONS.
41.	ALL CEILING DIFFUSERS ARE 4-WAY UNLESS OTHERWISE NOTED.
42.	PROVIDE BACK-DRAFT DAMPER FOR ALL EXHAUST AIR DUCT UNLESS OTHERWISE NOTED PER CODE.
43.	EXHAUST TERMINATION SHALL BE MINIMUM 10'-0" AWAY OR 3'-0" ABOVE FROM ANY FRESH AIR INTAKE, OPERABLE WINDOWS, DOORS AND 10'-0" MINIMUM ABOVE GRADE.
44.	PROVIDE ALL FRESH AIR INTAKES AND EXHAUST OUTLETS WITH HOOD, 1/2" GALVANIZED MESH SCREENS AND OUTSIDE AIR BACK-DRAFT DAMPERS.
45.	ALL HVAC UNITS OR SYSTEMS SERVING A COMMON AIR SPACE MUST BE INTERCONNECTED TO SHUT DOWN IMMEDIATELY UPON ALARM CONDITION FROM DUCT DETECTORS (OR FIRE ALARM SYSTEM WHEN USING AREA SMOKE DETECTORS IN LIEU OF DUCT DETECTORS) WITHOUT INTERFERENCE FROM EMS OR ANY OTHER SYSTEMS. ALL CONTROL RELAYS USED FOR SHUT DOWN MUST BE APPROVED BY STATE OR LOCAL JURISDICTION FOR RELEASING SERVICE.
46.	PURCHASING PARTY SHALL ENSURE THE MOTOR SPECS PRIOR TO ORDERING EXHAUST SYSTEM TO ENSURE THE PANEL IS BUILT CORRECTLY.
47.	REDWOOD SLEEPER OR PLATFORM FOR ROOF MOUNTED UNIT, DUCT PENETRATION, CUTTING AND PATCHING BY GENERAL CONTRACTOR, UNLESS OTHERWISE NOTED ON PLAN.
48.	42" MINIMUM GUARDS TO BE PROVIDED WHEN ROOF MOUNTED OR ROOF ACCESS EQUIPMENT THAT REQUIRE SERVICE ARE LOCATED WITHIN 10' OF A ROOF EDGE OR OPEN SIDE OF A WALKING SURFACE AND SUCH EDGE OR OPEN SIDE IS LOCATED MORE THAN 30" ABOVE THE ROOF SURFACE.

CA GREEN BUILDING NOTES	
5.504.1	TEMPORARY VENTILATION. IF THE HVAC SYSTEM IS USED DURING CONSTRUCTION, USE RETURN AIR FILTERS WITH A MERV OF 8. BASED ON ASHRAE 52.2-1999, OR AN AVERAGE EFFICIENCY OF 30% BASED ON ASHRAE 52.1-1992. REPLACE ALL FILTERS IMMEDIATELY PRIOR TO OCCUPANCY. APPLIES TO ADDITIONS OR ALTERATIONS.
5.504.3	COVERING OF DUCT OPENINGS AND PROTECTION OF MECHANICAL EQUIPMENT DURING CONSTRUCTION. AT THE TIME OF ROUGH INSTALLATION AND DURING STORAGE ON THE CONSTRUCTION SITE AND UNTIL FINAL STARTUP OF THE HEATING, COOLING AND VENTILATING EQUIPMENT, ALL DUCT AND OTHER RELATED AIR DISTRIBUTION COMPONENT OPENINGS SHALL BE COVERED WITH TAPE, PLASTIC SHEET METAL OR OTHER METHODS ACCEPTABLE TO THE ENFORCING AGENCY TO REDUCE THE AMOUNT OF DUST, WATER AND DEBRIS WHICH MAY ENTER THE SYSTEM.
5.504.5.3	IN MECHANICALLY VENTILATED BUILDINGS, PROVIDE REGULARLY OCCUPIED AREAS OF THE BUILDING WITH AIR FILTRATION MEDIA FOR OUTSIDE AND RETURN AIR PRIOR TO OCCUPANCY THAT PROVIDES AT LEAST A MERV OF 13.
5.506.1	FOR MECHANICALLY OR NATURALLY VENTILATED SPACES IN BUILDINGS, MEET THE MINIMUM REQUIREMENTS OF SECTION 120.1 OF THE CALIFORNIA ENERGY CODE AND CHAPTER 4 OF CCR, TITLE 8, OR THE APPLICABLE LOCAL CODE, WHICHEVER IS MORE STRINGENT.


DEMAND CONTROL VENTILATION NOTES	
2019 BUILDING ENERGY EFFICIENCY STANDARDS SECTION 120.1(D)(4)	
A.	For each system with demand control ventilation (DCV), CO2 sensors shall be installed in each room that meets the criteria of Section 120.1(d)(3) with no less than one sensor per 10,000 ft² of floor space. When a zone or a space is served by more than one sensor, a signal from any sensor indicating that CO2 is near or at the setpoint within the zone or space shall trigger an increase in ventilation.
B.	CO2 sensors shall be located in the room between 3 ft and 6 ft above the floor or at the anticipated height of the occupants' heads.
C.	Demand ventilation controls shall maintain CO2 concentrations less than or equal to 600 ppm plus the outdoor air CO2 concentration in all rooms with CO2 sensors. EXCEPTION to Section 120.1(d)(4C): The outdoor air ventilation rate is not required to be larger than the design outdoor air ventilation rate required by Section 120.1(c)(3) regardless of CO2 concentration.
D.	Outdoor air CO2 concentration shall be determined by one of the following: D.A. CO2 concentration shall be assumed to be 400 ppm without any direct measurement; or D.B. CO2 concentration shall be dynamically measured using a CO2 sensor located within 4 ft of the outdoor air intake.
E.	When the system is operating during hours of expected occupancy, the controls shall maintain system outdoor air ventilation rates no less than the rate listed in Table 120.1-A for DCV, times the conditioned floor area for spaces with CO2 sensors, plus the rate required by Section 120.1(c)(3) for other spaces served by the system, or the exhaust air rate whichever is greater.
F.	CO2 sensors shall be certified by the manufacturer to be accurate within plus or minus 75 ppm at a 600 and 1000 ppm concentration when measured at sea level and 25°C, factory calibrated, and certified by the manufacturer to require calibration no more frequently than once every 5 years. Upon detection of sensor failure, the system shall provide a signal which resets to supply the minimum quantity of outside air to levels required by Section 120.1(c)(3) to the zone served by the sensor at all times that the zone is occupied.
G.	The CO2 sensor(s) reading for each zone shall be displayed continuously, and shall be recorded on systems with DDC to the zone level.

CA TITLE 24 NOTES	
ADMINISTRATIVE REQUIREMENTS:	
A.	THE PERSON WITH OVERALL RESPONSIBILITY FOR CONSTRUCTION OR THE PERSON RESPONSIBLE FOR THE INSTALLATION OF REGULATED FEATURES, MATERIALS, COMPONENTS, OR MANUFACTURED DEVICES SHALL POST OR MAKE AVAILABLE WITH THE BUILDING PERMIT(S) ISSUED FOR THE BUILDING, THE REQUIRED INSTALLATION CERTIFICATE(S) FOR FEATURES, MATERIALS, COMPONENTS, OR MANUFACTURED DEVICES REGULATED BY THE APPLIANCE EFFICIENCY REGULATIONS OR PART 6. SUCH INSTALLATION CERTIFICATE(S) SHALL BE MADE AVAILABLE TO THE ENFORCEMENT AGENCY FOR ALL APPROPRIATE INSPECTIONS. THESE CERTIFICATES SHALL: A.1. IDENTIFY FEATURES, MATERIALS, COMPONENTS, OR MANUFACTURED DEVICES REQUIRED TO VERIFY COMPLIANCE WITH THE APPLIANCE EFFICIENCY REGULATIONS AND PART 6. A.2. INCLUDE A STATEMENT INDICATING THAT THE FEATURES, MATERIALS, COMPONENTS, OR MANUFACTURED DEVICES CONFORM TO THE APPLIANCE EFFICIENCY REGULATIONS AND PART 6 AND THE REQUIREMENTS FOR SUCH FEATURES, MATERIALS, COMPONENTS, OR MANUFACTURED DEVICES GIVEN IN THE PLANS AND SPECIFICATIONS APPROVED BY THE LOCAL ENFORCEMENT AGENCY. A.3. STATE THE NUMBER OF THE BUILDING PERMIT UNDER WHICH THE CONSTRUCTION OR INSTALLATION WAS PERFORMED.
B.	WITHIN 90 DAYS AFTER ISSUANCE OF CERTIFICATE OF OCCUPANCY RECORD DRAWINGS SHALL BE PROVIDED TO THE OWNER. IF A BUILDING DESIGN FEATURE, MATERIAL, COMPONENT OR MANUFACTURED DEVICE IS CHANGED BEFORE FINAL CONSTRUCTION AND INSTALLATION, SUCH THAT THE BUILDING MAY NO LONGER COMPLY WITH PART 6, THE BUILDING MUST BE BROUGHT INTO COMPLIANCE, AND SO INDICATED ON AMENDED PLANS AND CERTIFICATE OF COMPLIANCE(S) THAT SHALL BE SUBMITTED FOR APPROVAL.
C.	THE BUILDER SHALL PROVIDE THE BUILDING OWNER OR THE PERSON(S) RESPONSIBLE FOR BUILDING MAINTENANCE (IN CASE OF MULTI-TENANT OR CENTRALLY OPERATED BUILDINGS) AT OCCUPANCY THE FOLLOWING: C.1. OPERATING INFORMATION: THE APPROPRIATE CERTIFICATE(S) OF COMPLIANCE AND A LIST OF THE FEATURES, MATERIALS, COMPONENTS, AND MECHANICAL DEVICES INSTALLED IN THE BUILDING AND INSTRUCTIONS ON HOW TO OPERATE THEM EFFICIENTLY. C.2. MAINTENANCE INFORMATION: REQUIRED ROUTINE MAINTENANCE ACTIONS SHALL BE CLEARLY STATED AND INCORPORATED ON A READILY ACCESSIBLE LABEL. THE LABEL MAY BE LIMITED TO IDENTIFYING THE OPERATION AND MAINTENANCE MANUAL. C.3. VENTILATION INFORMATION: A DESCRIPTION OF THE QUANTITIES OF OUTDOOR AND RECIRCULATED AIR THAT THE VENTILATION SYSTEMS ARE DESIGNED TO PROVIDE TO EACH AREA.
MANDATORY MEASURES:	
A.	MANUFACTURED FENESTRATION AND EXTERIOR DOORS SHALL MEET ALL LISTED REQUIREMENTS IN SEC 10-111(A) UNDER SECTION 110.8(A) OF PART 6. TEMPORARY LABELS FOR MANUFACTURED FENESTRATION SHALL HAVE A CLEARLY VISIBLE TEMPORARY LABEL AND SHALL COMPLY WITH LABELING REQUIREMENTS OF NFRC 700. NO OTHER VALUES FOR U-FACTOR, SHGC, VT AND AIR LEAKAGE ARE ALLOWED ON THE TEMPORARY LABEL ATTACHED TO THE MANUFACTURED FENESTRATION PRODUCT OR EXTERIOR DOOR.
B.	RATED FENESTRATION SHALL HAVE A PERMANENT LABEL CONSISTENT WITH THEIR RATING AND CERTIFICATION THAT IS EITHER A STAND-ALONE LABEL, AN EXTENSION OR TAB OF AN EXISTING PERMANENT CERTIFICATION LABEL BEING USED BY THE MANUFACTURER/RESPONSIBLE PARTY, OR A SERIES OF MARKS OR ETCHINGS ON THE PRODUCT.
C.	JOINTS, PENETRATIONS AND OTHER OPENINGS IN THE BUILDING ENVELOPE THAT ARE POTENTIAL SOURCES OF AIR LEAKAGE SHALL BE CAULKED, GASKETED, WEATHER STRIPPED, OR OTHERWISE SEALED TO LIMIT INFILTRATION AND EXFILTRATION.
D.	ALL INSULATING MATERIAL SHALL BE INSTALLED IN COMPLIANCE WITH THE FLAME-SPREAD RATING AND SMOKE DENSITY REQUIREMENTS OF THE CBC.
E.	NON-CENTRALIZED ENERGY MANAGEMENT SYSTEMS SHALL HAVE SETBACK THERMOSTATS, CAPABLE TO PROGRAM TEMPERATURE SETPOINTS FOR AT LEAST FOUR PERIODS WITHIN A 24-HR. PERIOD.
F.	ALL RECIRCULATED AIR OR OUTDOOR AIR SUPPLIED TO OCCUPIABLE SPACES IS FILTERED (MINIMUM MERV 13) BEFORE PASSING THROUGH ANY AIR CONDITIONING COMPONENT; THE LESSER OF THE MINIMUM RATE OF OUTDOOR AIR REQUIRED BY SEC. 120.1 (C), OR THREE COMPLETE AIR CHANGES SHALL BE SUPPLIED TO THE ENTIRE BUILDING DURING THE ONE-HOUR PERIOD IMMEDIATELY BEFORE THE BUILDING IS NORMALLY OCCUPIED.
G.	ALL MECHANICAL VENTILATION AND SPACE-

PACKAGED ROOFTOP HEAT PUMP UNIT SCHEDULE																		
<div><div><div>EQ</div><div>#</div></div></div>	MARK	MAKE & MODEL	NOMINAL TONS	COOLING CAPACITY (BTUH)		HEATING CAPACITY (BTUH)	HSPF/ COP	SUPPLY FAN		POWER SUPPLY				EER/ SEER/ IEER	WEIG HT (LBS.)	UNIT DIMENSIONS (IN.)		
		(EQUIV. ACCEPTABLE)		TH	SH			CFM	HP	VOLT	PH	HZ	MCA/ MOCP			H	W	D
RTU - 1		TRANE WSC048H4	4	49,000	34,300	47,500	8.2 / -	1,600	1	460	3	60	12 / 15	12.3 / 14.3 / -	768	40-7/8	69-7/8	44-1/4
RTU - 2		TRANE WSC102H4	8.5	100,000	70,000	92,000	- / 3.4	3,400	2	460	3	60	20 / 30	11 / - / 12.2	1143	46-7/8	88-5/8	53-1/4
RTU - 3		TRANE WSC048H4	4	49,000	34,300	47,500	8.2 / -	1,600	1	460	3	60	12 / 15	12.3 / 14.3 / -	768	40-7/8	69-7/8	44-1/4
RTU - 4		TRANE WSC120H4	10	115,000	80,500	106,000	- / 3.4	4,000	2.75	460	3	60	24 / 35	11 / - / 12.2	1164	46-7/8	88-5/8	53-1/4
NOTES:																		
1	INSTALL WITH DISCONNECT SWITCH AND ALL WEATHERPROOF GFCI.																	
2	THERMOSTATS INSTALLED AT 48" AFF W/ REMOTE SENSORS.																	
3	PROVIDE STANDARD THROWAWAY CONSTRUCTION FILTERS OF MERV 13. MECHANICAL CONTRACTOR SHALL FURNISH AND FIELD INSTALL NEW FILTER PRIOR TO BUILDING OCCUPANCY (INCLUDING FOR INTERNAL PRESSURE DROP.																	
4	EXTEND CONDENSATE DRAIN DIRECTLY TO A LOCAL CODE APPROVED RECEPTOR.																	
5	PROVIDE REMOTE ALARM INDICATORS FOR THE SUPPLY AIR SMOKE DETECTORS CLEARLY LABELED AS TO FUNCTION AND UNIT SERVED.																	
6	DUCT SMOKE DETECTORS SHALL BE PROVIDED FOR SYSTEMS HAVING A GREATER THAN 2,000 CFM CAPACITY ON SUPPLY PLENUM. KEYED REMOTE TEST SWITCHES WITH LED LIGHT INDICATOR ARE TO BE PROVIDED ON THE WALL AT NO GREATER THAN 6 FEET FOR ALL DUCT DETECTORS. DUCT DETECTOR ACTIVATION SHALL RESULT IN COMPLETE SHUT DOWN OF HVAC UNITS AND NOTIFICATION TO THE FIRE ALARM SYSTEM IN THE FORM OF A SUPERVISORY SIGNAL.																	
7	PROVIDE AN INTEGRATED ECONOMIZER WITH FAULT DETECTION DIAGNOSTICS (FDD) FOR EACH INDIVIDUAL COOLING SPACE CONDITIONING SYSTEM THAT HAS A TOTAL COOLING CAPACITY OVER 54,000 BTU/HR.																	

VENTILATION SCHEDULE						
Room	AREA	OSA REQUIRED		EXHAUST REQUIRED		
	AREA(S.F.)	RATE(CFM/SF)	REQUIRED CFM	RATE(CFM/SF)	REQUIRED CFM	PROVIDED CFM
BREAK ROOM	1120	0.5	560	0.00	0	0
WAREHOUSE	3205	0.15	480.75	0.00	0	0
DECK	3405	0.15	510.75	0.00	0	0
GYM	920	0.15	138	0.00	0	0
TOTAL REQUIRED:			1551.5			
TOTAL PROVIDED:			1900			

GRAVITY VENTILATOR SCHEDULE								
<div><div>EQ</div><div>#</div></div>	MARK	EQUIP.	CFM	THROAT WIDTH X LENGTH	CURB CAP WIDTH X LENGTH	WT (LBS)	MANUFACTURER & MODEL NO.	REMARKS
	GV - 1	GRAVITY INTAKE	11,721	24 X 66	30 X 72	174	GREENHECK FGI	1,2,3
	GV - 2	GRAVITY RELIEF	13,871	24 X 84	30 X 90	178	GREENHECK FGR	1,2,3
REMARKS:								
1	EQUIVALENT ACCEPTABLE.							
2	INSTALL WITH BACKDRAFT DAMPER.							
3	PROVIDE DUCT FROM GRAVITY VENTILATOR TO CEILING AIR DEVICES.							

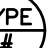TYPE 							
MARK	FACE SIZE	TYPE	MOUNTING TYPE	DIRECTION	MANUF.	NOTES	
S-1	24X24	SUPPLY	SURFACE/ LAY-IN	4-WAY	TITUS (OR EQUIV.)	1,2,3,4	
R-1	24X24	RETURN	SURFACE/ LAY-IN	1-WAY	TITUS (OR EQUIV.)	1,2,3	
NOTES:							
1. PROVIDE NECESSARY MOUNTING HARDWARE AND ACCESSORIES AS REQUIRED.							
2. ALL AIR DEVICES SHALL HAVE MANUFACTURER-APPLIED STANDARD WHITE FINISH UNLESS NOTED OTHERWISE. REFER TO ARCHITECTURAL DRAWINGS FOR RCP COORDINATION.							
3. AIR DEVICE SHALL BE OF STEEL CONSTRUCTION.							
4. AIR DEVICE SHALL BE INSTALLED COMPLETE WITH MANUFACTURER AVAILABLE MOLDED INSULATION BACKING. FIELD-FABRICATED INSULATION BACKING IS NOT ALLOWED UNLESS FIRST APPROVED BY THE OWNER'S CONSTRUCTION MANAGER.							





CDI Circa Domini International, Inc.

Engineering - Consulting
16520 Bake Pkwy, Suite 100, Irvine, CA
Phone (949) 336-6636 | dkang@cdieng.com



GST OFFICE

12881 166TH STREET,
CERRITOS, CA 90703

REVISION
PLAN CHECK REV. 06/30/2022
REVISION 10-14-22

DATE:
03/22/2022


SCALE:

SHEET TITLE:
MECHANICAL
SCHEDULES

M001


NOTE:
WHERE DUCT IS LARGER THAN 20" USE 2 1/2" x 2 1/2" x 16 GA. VERTICAL
ANGLE IN PLACE OF HANGER STRAP AT EACH SEISMIC BRACE.

HANGER STRAP SCHEDULE			
DUCT SIZE	STRAP SIZE	MAX. LOAD EA. HANGER	MAX. SPACING
UP THRU 10"	1" x 22 GA.	260 LBS	10'-0"
11" TO 18"	1" x 22 GA.	260 LBS	10'-0"
19" TO 24"	1" x 22 GA.	260 LBS	10'-0"
25" TO 36"	1" x 20 GA.	320 LBS	10'-0"

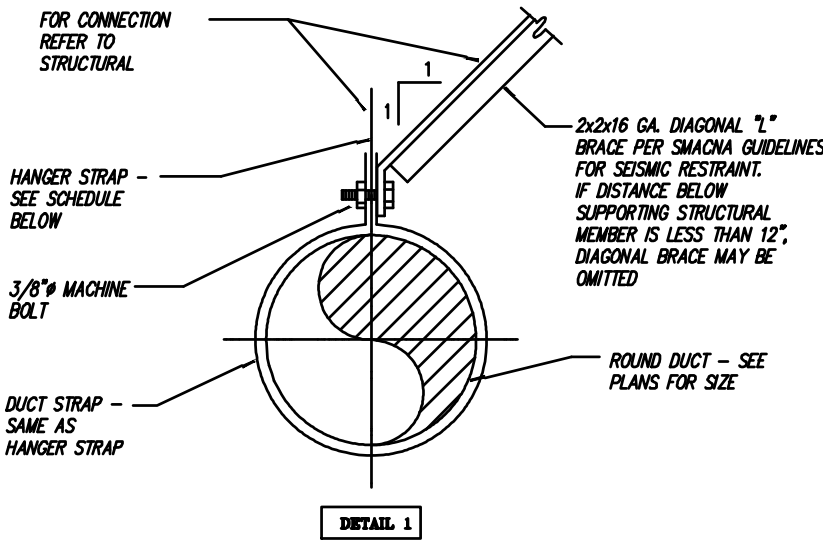

ROUND DUCT

RECTANGULAR DUCT

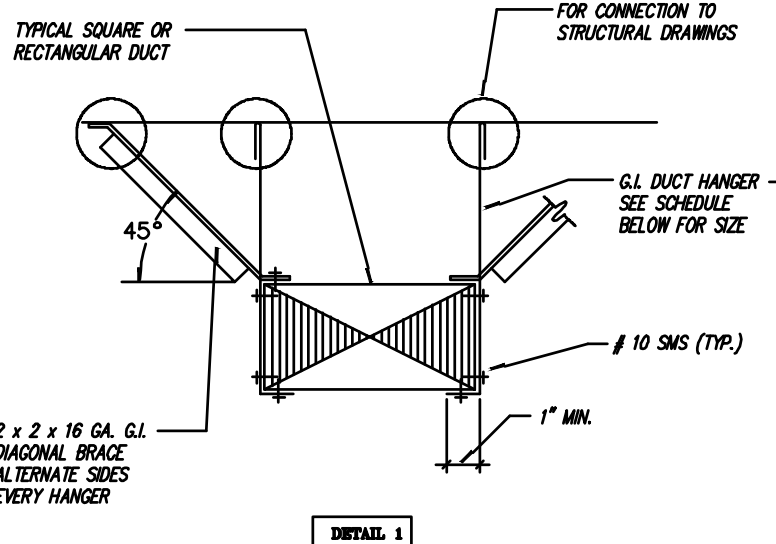


NOTE:
WHERE DUCT IS 6 SF. OR LARGER IN CROSS SECTIONAL AREA - USE
2 1/2" x 2 1/2" x 16 GA. VERTICAL ANGLE IN PLACE OF HANGER AT
SEISMIC BRACE.

MAX. HALF OF DUCT PERIMETER	MAX. LOAD EACH HANGER	HANGER SIZE	HANGER SPACING
P/2 = 30"	260 LBS	1" x 22 GA.	10'-0" O/C
P/2 = 72"	420 LBS	1" x 18 GA.	10'-0" O/C
P/2 = 96"	700 LBS	1" x 16 GA.	10'-0" O/C
P/2 = 120"	1100 LBS	1 1/2" x 16 GA.	10'-0" O/C

DUCT MOUNTING DETAIL

SCALE:
N.T.S.

1

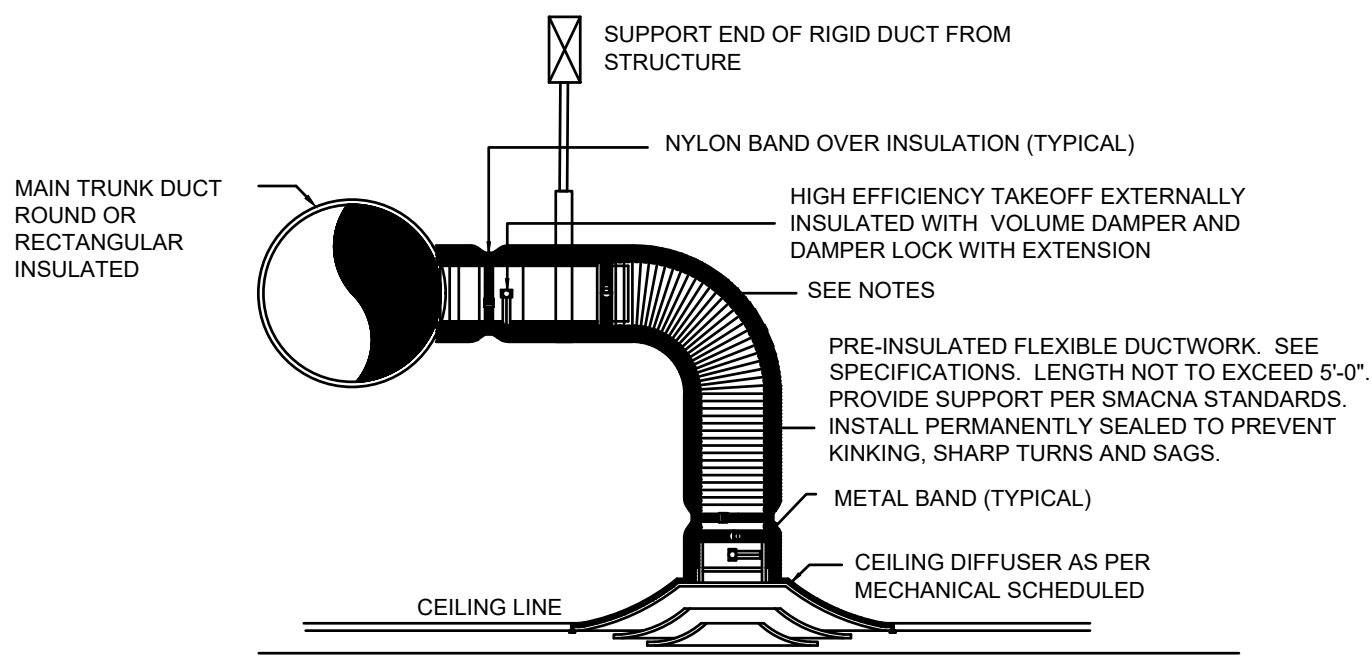

NOTE: EXTEND HARD METAL DUCT SO THAT MAXIMUM FLEXIBLE DUCT LENGTH DOES NOT EXCEED 5'-0". PROVIDE RIGID 90° ELBOW WHERE REQUIRED TO KEEP FLEXIBLE DUCT WITHIN 5'-0" LENGTH LIMITATION.

CEILING DIFFUSER DETAIL

SCALE:
N.T.S.

2



GST OFFICE

12881 166TH STREET,
CERRITOS, CA 90703

REVISION	REVISION
PLAN CHECK REV. 06/30/2022	REVISION 10-14-22

DATE: 03/22/2022


SHEET TITLE:
MECHANICAL
DETAILS

M002

BUILDING AND SAFETY DIVISION
Department of Public Works
FINAL ENERGY APPROVED
UNDER CCR TITLE 24, PART 1,
ARTICLE 1 & PART 6
ERLEITER
PUBLIC WORKS
11/02/2022 10:31:16 AM
This set of plans and specifications shall not apply at the job site as all times, and is unlawful to violate any changes, modifications or alterations to these plans or specifications without the prior written permission of the Building Official. The turning of this set of plans and specifications SHALL NOT, under any circumstances, be deemed to permit or to be an approval of any work or activity that violates any provisions of any County Ordinance or State Law.

MECHANICAL PLAN - 1ST FLOOR

(E)1ST FLOOR
NOT PART OF WORKS

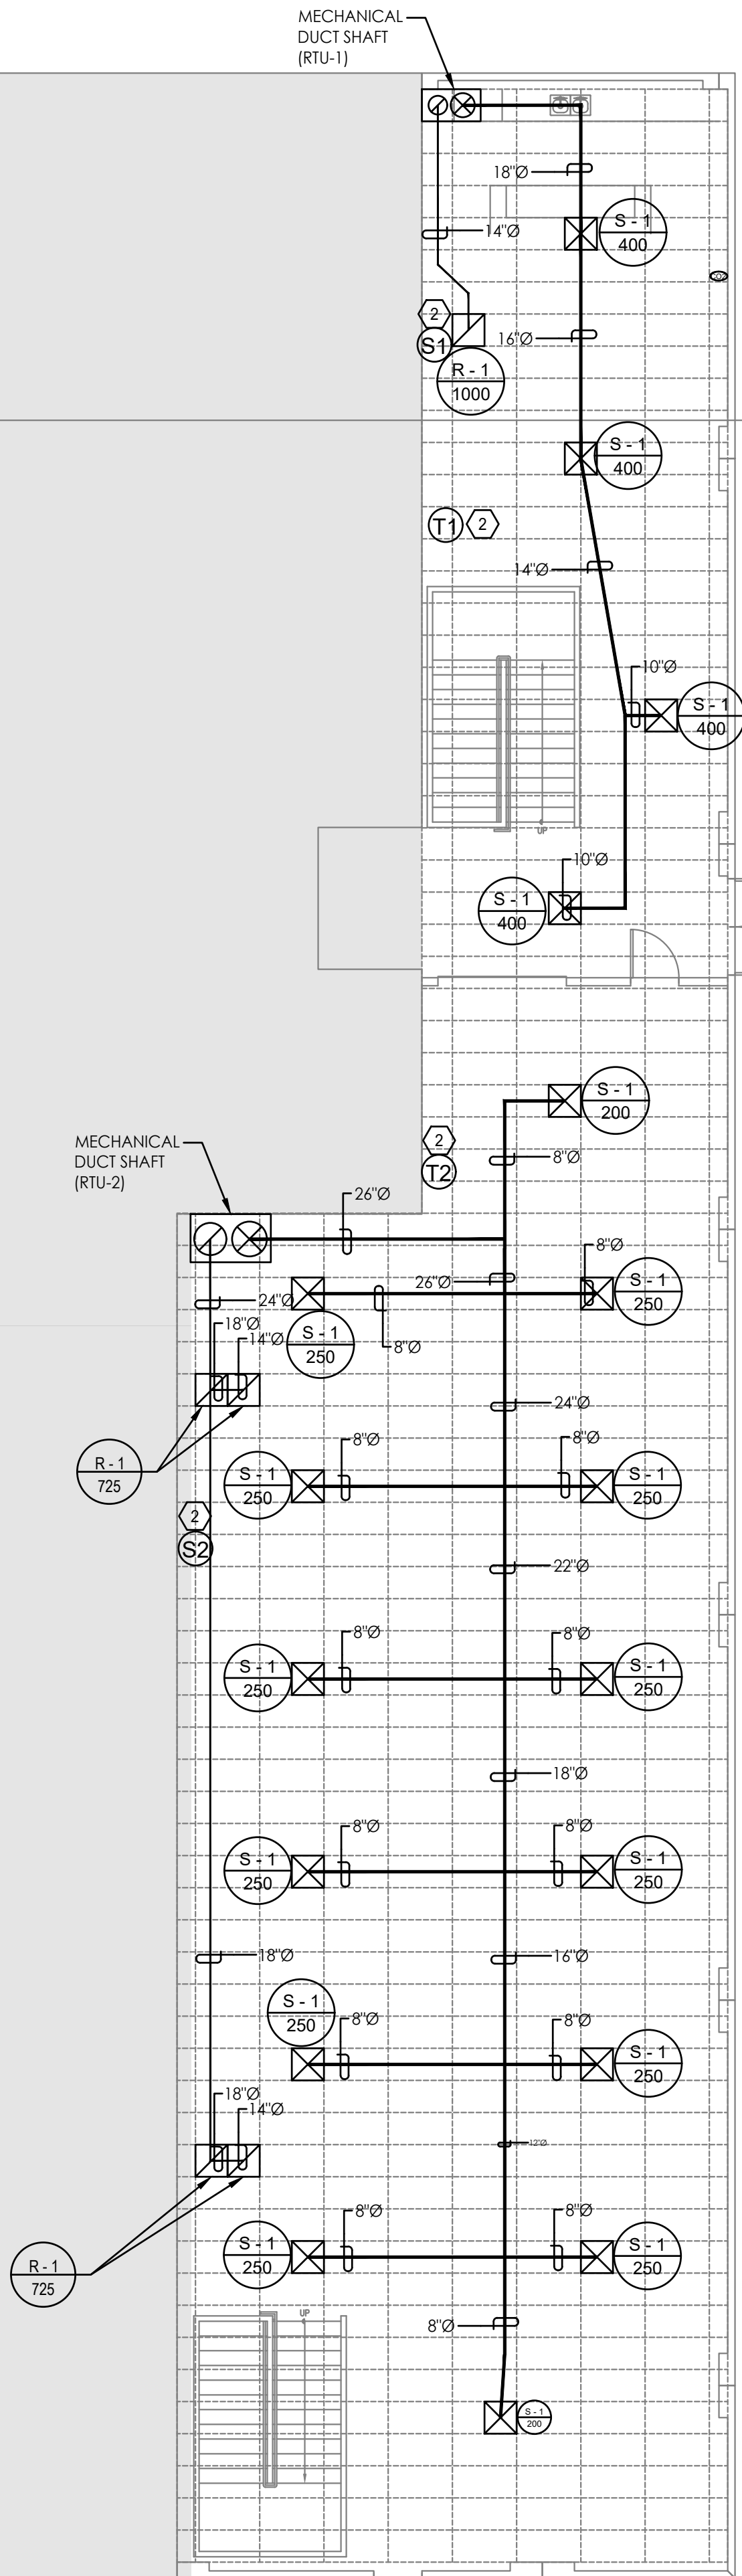

- KEYED PLAN NOTES:**
- OPEN TO ABOVE.
 - INSTALL PROGRAMMABLE THERMOSTAT 48" AFF AND MOUNT REMOTE SENSORS HIGH ON WALL.
- GENERAL NOTES:**
- IF DRAWINGS ARE INCORRECT FROM THE ACTUAL SITE, CONDITION, CONTRACTOR SHALL NOTIFY ENGINEER(S) AND PROVIDE INFORMATION REFLECTING ACTUAL CONDITIONS.



GST OFFICE


12881 166TH STREET,
CERRITOS, CA 90703

REVISION									
PLAN CHECK REV. 06/30/2022									
REVISION 10-14-22									
DATE: 03/22/2022	SCALE: 1/8" = 1'-0"								
SHEET TITLE: MECHANICAL PLAN - 1ST FLOOR									

M100

MECHANICAL PLAN - 2ND FLOOR

(E)2ND FLOOR
NOT PART OF WORKS

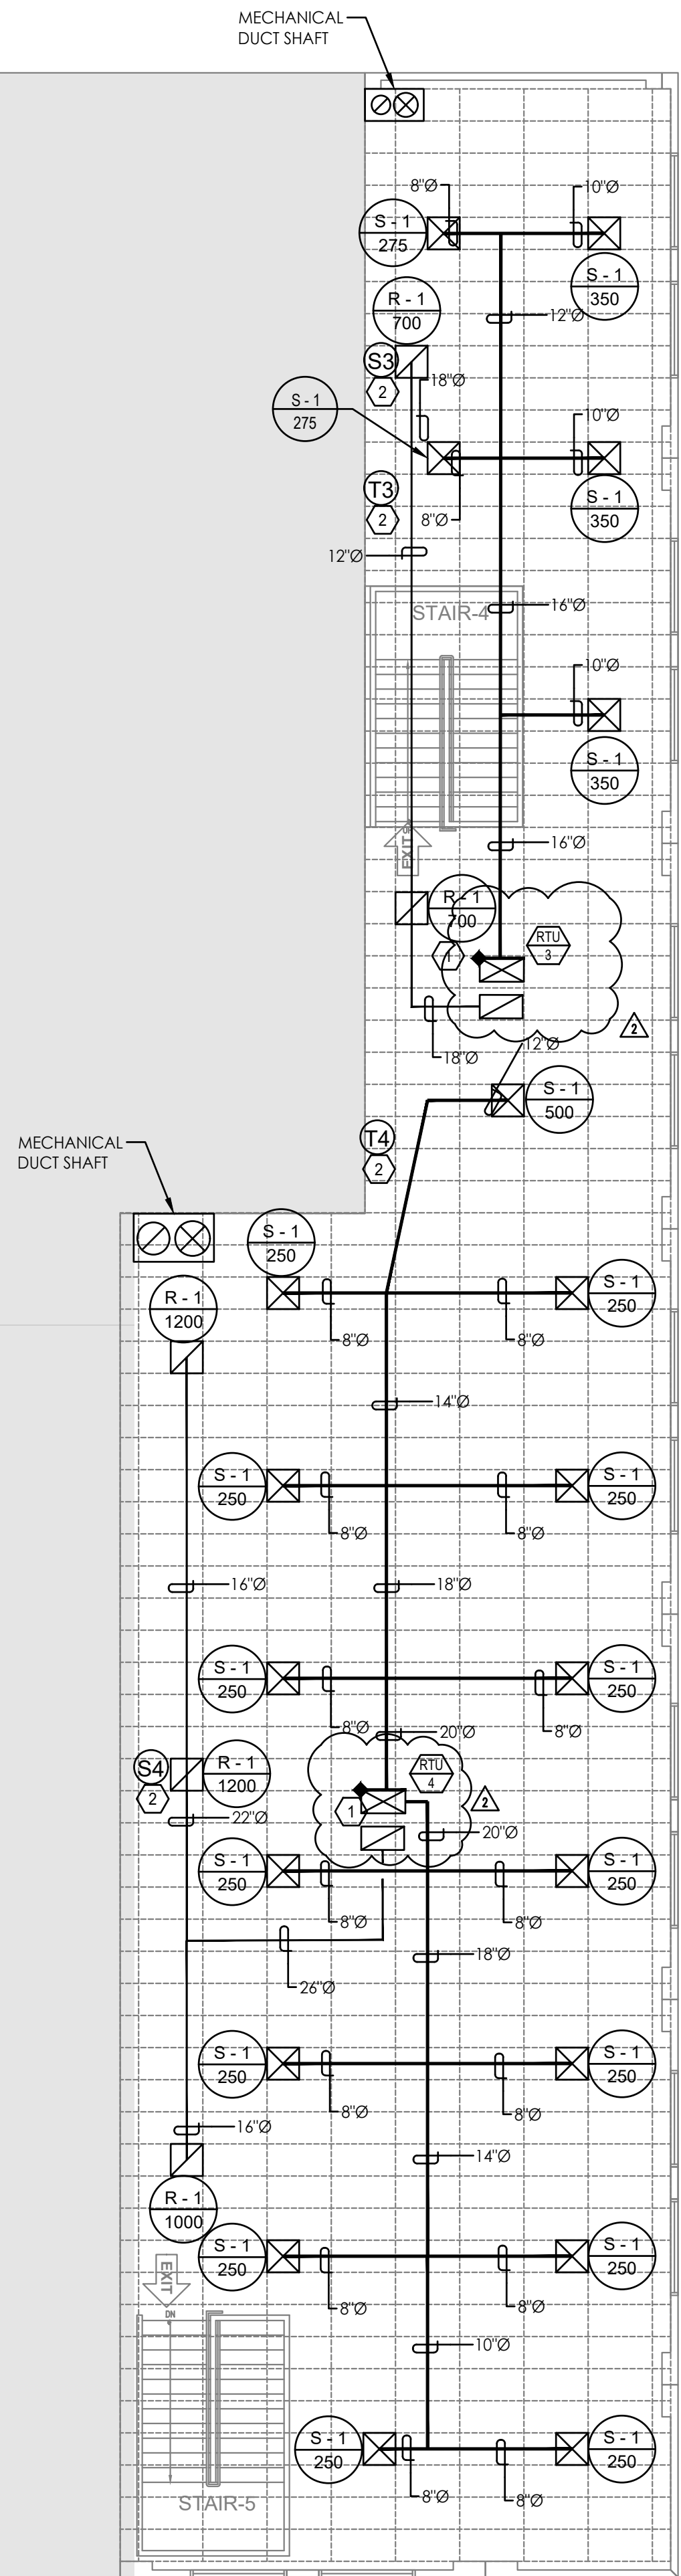

- # KEYED PLAN NOTES:**
1. INSTALL DUCT SMOKE DETECTOR ON SUPPLY SIDE PLENUM.
 2. INSTALL PROGRAMMABLE THERMOSTAT 48" AFF AND MOUNT REMOTE SENSORS HIGH ON WALL.

- GENERAL NOTES:**
1. IF DRAWINGS ARE INCORRECT FROM THE ACTUAL SITE CONDITION, CONTRACTOR SHALL NOTIFY ENGINEER(S) AND PROVIDE INFORMATION REFLECTING ACTUAL CONDITIONS.



GST OFFICE


12881 166TH STREET,
CERRITOS, CA 90703

REVISION	
PLAN CHECK REV. 06/30/2022	REVISION 10-14-22

DATE: 03/22/2022
SCALE: 1/8" = 1'-0"

SHEET TITLE:
MECHANICAL PLAN -
2ND FLOOR

M101

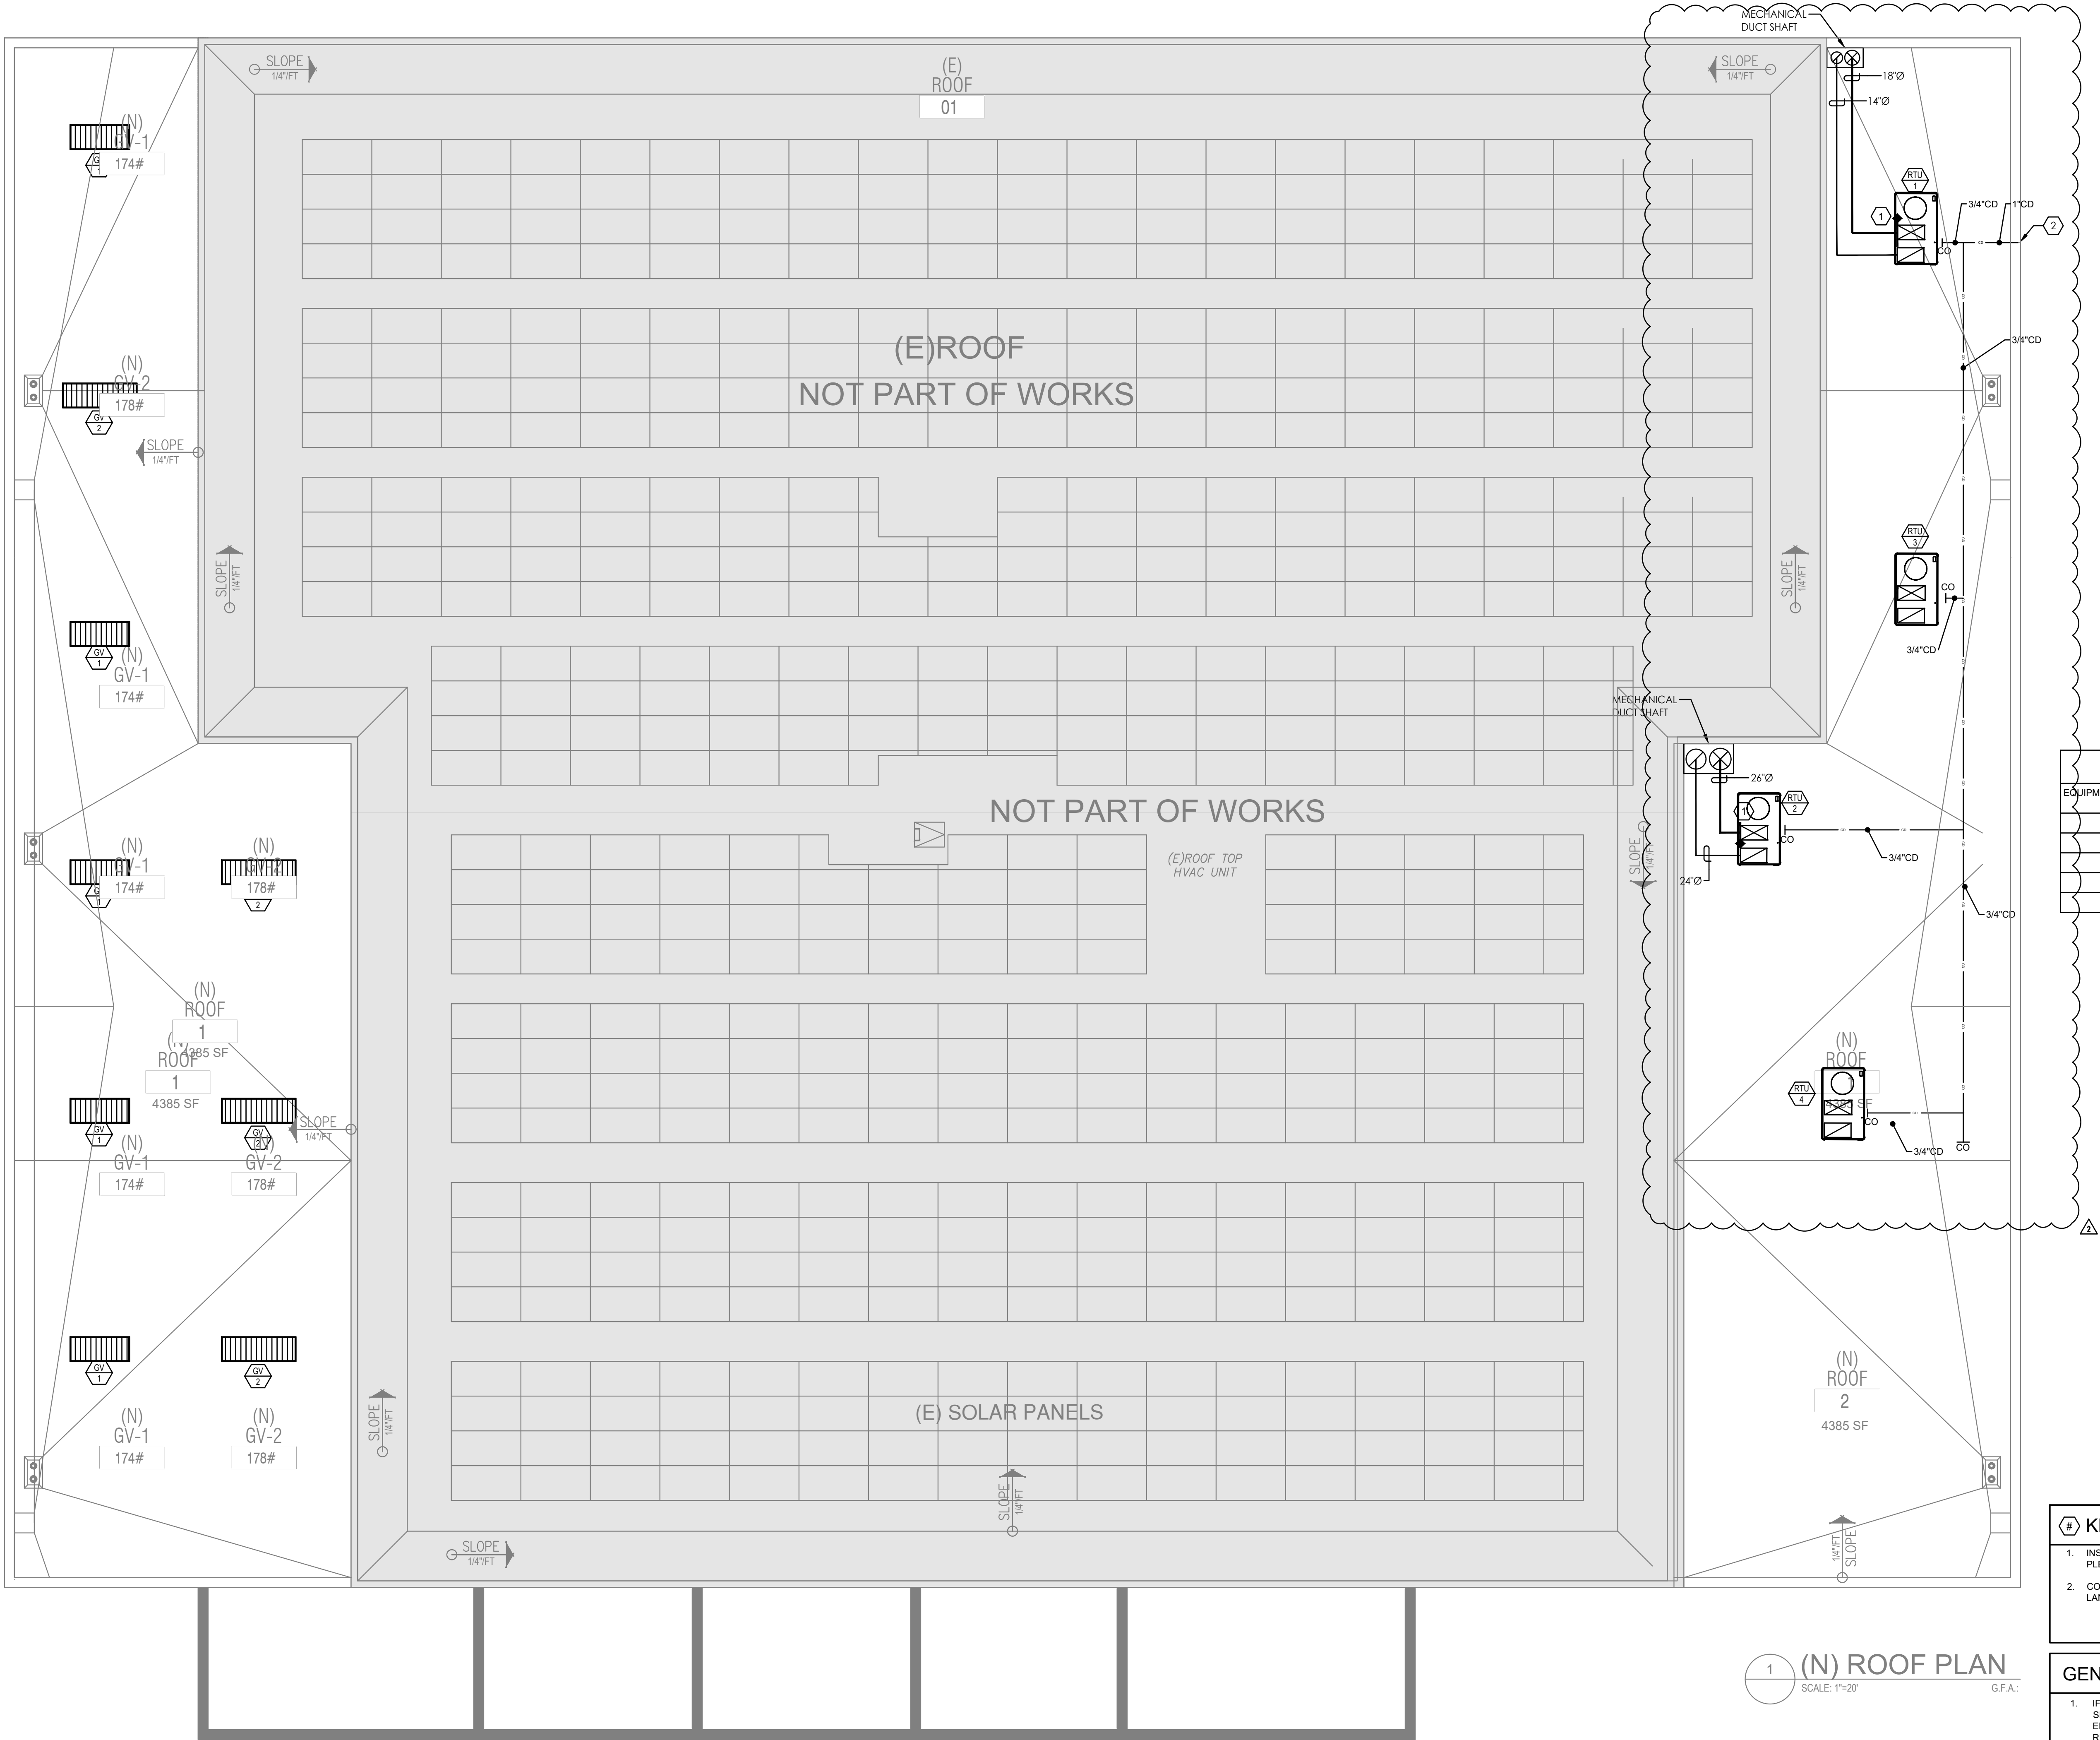

MINIMUM CONDENSATE PIPE SIZE	
EQUIPMENT CAPACITY IN TONS OF REFRIGERATION	MINIMUM CONDENSATE PIPE DIAMETER
UP TO 20	3 / 4
21-40	1
41-90	1-1/4
91-125	1-1/2
126-250	2



- KEYED PLAN NOTES:**
1. INSTALL DUCT SMOKE DETECTOR ON SUPPLY SIDE PLENUM.
 2. CONDENSATE PIPE RUN ALONG WALL AND SPILL TO LANDSCAPE AREA.

- GENERAL NOTES:**
1. IF DRAWINGS ARE INCORRECT FROM THE ACTUAL SITE CONDITION, CONTRACTOR SHALL NOTIFY ENGINEER(S) AND PROVIDE INFORMATION REFLECTING ACTUAL CONDITIONS.
 2. CONDENSATE DRAIN SLOPE AT MIN. 1%.



REVISION	PLAN CHECK REV. 06/30/2022	REVISION 10-14-22
DATE:	03/22/2022	SCALE:
SHEET TITLE:	MECHANICAL PLAN - ROOF	1/8" = 1'-0"

STATE OF CALIFORNIA

Envelope Component Approach

REC-ENVC

CALIFORNIA ENERGY COMMISSION

NRCC-ENVC

CERTIFICATE OF COMPLIANCE

This document is used to demonstrate compliance with mandatory requirements in [§110.8\(a\)](#), and [§120.7\(b\)\(3\)](#) for newly constructed buildings, and [§141.0\(b\)\(1\)](#) for alterations, related to roof, wall and floor assemblies. It is also used to demonstrate compliance with prescriptive requirements in [§140.3\(a\)](#) for newly constructed buildings, and [§141.0](#) for additions and alterations, related to roof, wall, floor, door, fenestration and daylighting requirements.

Project Name:

GTS Office

Report Page:

(Page 1 of 11)

Project Address:

12881 166th Street

Date Prepared:

4/13/2022

A. GENERAL INFORMATION

01	Project Location (city)	Cerritos	05	# of Stories (Habitable Above Grade)	1
02	Zipcode	90703	06	Total Conditioned Floor Area (ft ²)	8650
03	Climate Zone	8	07	Total Unconditioned Floor Area (ft ²)	0
04	Occupancy Types Within Project: (select all that apply). If one occupancy constitutes > 80% of the conditioned floor area, the entire building envelope may be designed to comply with the provisions of that occupancy per §140.3(b)(3) .	<div> <div>08</div> <div> <div>Project includes unconditioned enclosed space(s) > 5,000 ft² under a roof with a ceiling height of at least 15 ft.¹</div> <div> <div><input type="checkbox"/></div> <div>Project includes unconditioned enclosed space(s) > 5,000 ft² under a roof with a ceiling height of at least 15 ft.¹</div> </div> </div> </div>			
All Nonresidential, including Relocatable Public School		<div> <div><input type="checkbox"/></div> <div>Relocatable Public School Building for use in all climate zones Occupancy: E</div> <div><input type="checkbox"/></div> <div>High-Rise Residential: R-2 / R-3</div> <div><input type="checkbox"/></div> <div>Hotel/Motel Guest Rooms Occupancy: R-1</div> </div>			
<div> <div><input type="checkbox"/></div> <div>Building certified for use in one climate zone Occupancy: A/B/E/F/H/M/J/S/U</div> </div>					

¹ FOOTNOTE: Enclosed spaces > 5,000 ft² directly under roof with ceiling height > 15 ft in climate zones 2 through 15 are required to meet the minimum daylighting requirements defined in [§140.3\(c\)](#). Compliance with [§140.3\(c\)](#) is documented in table L. This is the only prescriptive requirement which applies to unconditioned spaces.

B. PROJECT SCOPE

This table specifies project envelope components within the permit application demonstrating compliance using the prescriptive paths outlined in [§140.3](#), and [§141.0\(a\)\(1\)](#) and [§141.0\(b\)\(1\)](#) and 2 for additions and alterations.

My project consists of (check all that apply)		Component Types					
G1		G2					
<input checked="" type="checkbox"/>	New Construction or Newly Conditioned Space	<input checked="" type="checkbox"/>	Roof	<input checked="" type="checkbox"/>	Walls	<input checked="" type="checkbox"/>	Exterior Doors
<input type="checkbox"/>	One or more enclosed spaces > 5,000 ft ² directly under roof with ceiling height > 15ft.	<input checked="" type="checkbox"/>	Floors	<input type="checkbox"/>	Fenestration/ Glazed Doors ¹	<input type="checkbox"/>	
<input type="checkbox"/>	Addition of conditioned space	<input type="checkbox"/>	Walls	<input type="checkbox"/>	Exterior Doors	<input type="checkbox"/>	
<input type="checkbox"/>	One or more enclosed spaces > 5,000 ft ² directly under roof with ceiling height > 15ft.	<input type="checkbox"/>	Floors	<input type="checkbox"/>	Fenestration/ Glazed Doors ¹	<input type="checkbox"/>	
<input type="checkbox"/>	Alteration of conditioned space	<input type="checkbox"/>	Roof Assembly	<input type="checkbox"/>	Walls	Exterior Doors NA. for Alts.	
<input type="checkbox"/>	One or more enclosed spaces > 5,000 ft ² directly under roof with ceiling height > 15ft and lighting system installed for the first time	<input type="checkbox"/>	Roofing Material	<input type="checkbox"/>	Floors	Fenestration/ Glazed Doors	

¹ FOOTNOTE: Doors that are more than 25% glass in area are considered Glazed Doors and should be documented on table K with fenestration.

Registration Number:

Registration Date/Time:

Registration Provider: Energysolv

CA Building Energy Efficiency Standards - 2019 Nonresidential Compliance

Report Version: 2019.3.001

Report Generated: 2022-04-13 08:14:13

Schema Version: rev 20200601

STATE OF CALIFORNIA

Envelope Component Approach

NRCC-ENR-E

CERTIFICATE OF COMPLIANCE

Project Name:

GTS Office

Report Page:

NRCC-BW-A

Project Address:

12881 166th Street

Date Prepared:

Page 2 of 11

4/13/2022

C COMPLIANCE RESULTS

Results in this table are automatically calculated from data input and calculations in Tables F through L. Note: If any cell on this table says "COMPLIES with Exceptional Conditions" refer to Table D. Exceptional Conditions for guidance or see the applicable table referenced below.

Quapace Envelope Components						Fenestration	Daylighting Spaces > 5,000sf?	Compliance Results
Roof Assembly	Roofing Materials	Walls	Floors	Doors				
01	02	03	04	05	06		07	08
(See Table F)	(See Table G)	(See Table H)	(See Table I)	(See Table J)	(See Table K)	(See Table L)		COMPLIES
Yes	Yes	Yes		Yes	Yes			

D. EXCEPTIONAL CONDITIONS

This table is auto-filled with uneditable comments because of selections made or data entered in tables throughout the form.

E. ADDITIONAL REMARKS

This table includes remarks made by the permit applicant to the Authority Having Jurisdiction.

F. ROOF ASSEMBLY SCHEDULE

This table demonstrates compliance for prescriptive roof assembly requirements in [§140.3\(a\)\(18\)](#) for new construction or additions, or [§141.0\(b\)\(28\)\(i\)](#) for alterations.

01

Indicate roof types included in the project:

☒ Framed

☐ SIPs

☐ Span Deck & Concrete

☐ Metal Panels

☐ Metal Building

Framed Roof Assemblies			
01	<input checked="" type="checkbox"/>	Include Framed Roof Assemblies in Area-Weighted Average U-factor Calculation ¹	
02	03	04	05
Tag/Plan Detail ID	Name/Description	Status	Exception to Roof Insulation Requirements in §141.0(b)(28)(i) (Alts. Only)
R-21 Roof Cathedral	Roof	New	
R-21 Roof Cathedral	Roof	New	
			Occupancy Type
			Nonresidential/ Relocatable 1 CZ
			Nonresidential/ Relocatable 1 CZ

Registration Number:

Registration Date/Time:

Registration Provider: Energysoft

CA Building Energy Efficiency Standards - 2019 Nonresidential Compliance

Report Version: 2019.1.002

Schema Version: rev 20200601

Report Generated: 2022-04-23 18:14:13

STATE OF CALIFORNIA

Envelope Component Approach

NBCC-ENVE

CERTIFICATE OF COMPLIANCE

Project Name

GTS Office

Report Page:

Project Address:

12881 166th Street

Date Prepared:

CALIFORNIA ENERGY COMMISSION

NBCC-ENVA

(Page 3 of 11)

4/13/2023

F. ROOF ASSEMBLY SCHEDULE

07	08	09	10	11	12	13	14	15	16	
Tag/Plan Detail ID	How Design U-factor was determined	Roof Type & Frame Material	Frame Spacing Depth	Cavity Insulation per Design	Continuous Insulation per Design	Thermal Performance Unit	Required Thermal Performance	U-factor per Design	Net Area ² ft²	
Roof	JA4 Tables	Wood		21	0	U-factor	0.049	per JA4 per Software/ Other	0.048	3205
Roof	JA4 Tables	Wood		21	0	U-factor	0.049	per JA4 per Software/ Other	0.048	1120

FOOTNOTES: If any individual assembly is non-compliant, assemblies may show compliance using an area-weighted calculation. Metal building roofs may not be combined with other roof types. The area-weighted compliance option is not available for alterations demonstrating compliance with R-values in Table 141.0-C.

If "R-value" is shown in cell 13 as the Thermal Performance Unit, the R-value shown here is for continuous insulation per Table 141.0-C.

U/Roof area minus any fenestrations/skylight area

Structural Insulated Panels (SIPs) Roofs/Ceiling Assemblies

Span Deck And Concrete Roof Assemblies

Metal Panel Assemblies

Metal Building Roof Assemblies

Area-Weighted Average U-factor Compliance Calculation for Framed/ SIPs/ Span Deck & Concrete/ Metal Panel Roofs

01	02	03	04	05
Roof Type	Total Area of Roof Type (ft²)	Area-weighted U-factor for Roof Type Required	Designated	Compliance Results Using Area-Weighted Calculation Option
Framed	4325	0.049	0.048	
Total for all Roof Types:	4325	0.049	0.048	COMPLIES

Area-Weighted Average U-factor Compliance Calculation for Metal Building Roof

01	02	03	04	05
Roof Type	Total Area of Roof Type (ft²)	Area-weighted U-factor for Roof Type Required	Designated	Compliance Results Using Area-Weighted Calculation Option
Framed	4325	0.049	0.048	
Total for all Roof Types:	4325	0.049	0.048	COMPLIES

Registration Number:

Registration Date/Time:

Registration Provider: Energysoft

CA Building Energy Efficiency Standards - 2019 Nonresidential Compliance

Report Version: 2019.1.009

Report Generated: 2022-04-13 18:14:13

Schema Version: rev 20200601

STATE OF CALIFORNIA

Envelope Component Approach

NRCC-ENV-E

CALIFORNIA ENERGY COMMISSION

CERTIFICATE OF COMPLIANCE

Project Name:	OTS Office	Report Page:	NRCC-ENV-E (Pages 4 of 11)
Project Address:	12881, 166th Street	Date Prepared:	4/13/2022

G. RATED ROOFING MATERIAL (COOL ROOF)

This table demonstrates compliance with prescriptive roof material requirements in [§140.3\(a\)\(14\)](#) for new construction or additions, or [§141.0\(b\)\(28\)](#) for alterations.

01	02	03	04	05	06	07	08	09	10
Tag/Plan Detail ID	Name/Description	Status	Occupancy Type	Roof Slope	Roof Material	Compliance Method	Required Minimum Material Performance	Designed Material Performance	U-factor of Assembly
R-21 Roof Cathedral	Roof	New	Nonresidential/ Relocatable 1 CZ	<2:12 (Low)	To Be Determined	Solar Reflectance (Aged)/ Emissance	Reflectance 0.63 Emissance 0.75 SRI	Reflectance 0.63 Emissance 0.75 SRI	0.63 0.75

H. WALL ASSEMBLY SCHEDULE

This table demonstrates compliance with prescriptive wall assembly requirements in [§140.3\(a\)\(2\)](#) and [§140.3\(a\)\(3\)](#) for new constructions or additions, or mandatory wall assembly requirements in [§141.0\(b\)\(18\)](#) for alterations.

01	Indicate wall types included in the project: ¹	<input checked="" type="checkbox"/> Framed	<input type="checkbox"/> Mass (new only)	<input type="checkbox"/> Concrete Sandwich Panel (new only)	<input type="checkbox"/> SIPs	<input type="checkbox"/> CF (new only)
		<input type="checkbox"/> Metal Panels	<input type="checkbox"/> Metal Building	<input type="checkbox"/> Spandrel/ Curtain Wall	<input type="checkbox"/> Straw Bale	<input type="checkbox"/> Log Home (new only)

¹ FOOTNOTES: Wall types indicated above as "(new only)" do not have Title 24, Part 6 requirements for alterations. New construction and additions do have requirements and should be divided above and compliance demonstrated within this table.

Framed Walls

01	<input type="checkbox"/>	Calculate Area-Weighted Average U-factor for Metal Framed Walls ¹									
02	<input checked="" type="checkbox"/>	Include Wood Framed Walls in Area-Weighted Average U-factor Calculation ¹									
03	04	05	06	07	08	09	10	11	12	13	
Tag/Plan Detail ID	Occupancy & Status	How Design U-factor was determined	Location	Frame Material, Spacing & Depth	Cavity Insulation per Design	Continuous Insulation per Design	Thermal Performance Unit	Required Thermal Performance	U-factor per Design	Net Area ² ft ²	
North Exterior Wall	Nonresidential/ Relocatable 1 CZ: New	IA4 Tables	Exterior wall	Wood 1/2" gyp 16" OC 2x4	13	0	U-factor	0.102	per IA4 per Software/ Other	0.102	214

Registration Number:

Registration Date/Time:

Registration Provider: Energysolv

CA Building Energy Efficiency Standards - 2019 Nonresidential Compliance

Report Version: 2019.1.30
Schema Version: rev 20200601

Report Generated: 2022-04-13 08:14:13

STATE OF CALIFORNIA

Envelope Component Approach

NRCC-ENVE

CERTIFICATE OF COMPLIANCE

Project Name:

075 Office

Report Page:

Project Address:

12881 166th Street

Date Prepared:

Page 5 of 41

4/13/2022

NRCC-BVIA

SALFORD ENERGY COMMISION

H. WALL ASSEMBLY SCHEDULE

03	04	05	06	07	08	09	10	11	12	13	
Tag/Plan Detail ID	Occupancy & Status	How Design U-factor was determined	Location	Frame Material, Spacing & Depth	Cavity Insulation per Design	Continuous Insulation per Design	Thermal Performance Unit	Required Thermal Performance	U-factor per Design	Net Area³ ft²	
East Exterior Wall	Nonresidential/Relocatable 1 CZ: New	IA4 Tables	Exterior wall	Wood 1/2" gyp 16" OC 2x4	13	0	U-factor	0.102	per IA4 per Software/ Other	0.102	303
South Exterior Wall	Nonresidential/Relocatable 1 CZ: New	IA4 Tables	Exterior wall	Wood 1/2" gyp 16" OC 2x4	13	0	U-factor	0.102	per IA4 per Software/ Other	0.102	357
East Exterior Wall	Nonresidential/Relocatable 1 CZ: New	IA4 Tables	Exterior wall	Wood 1/2" gyp 16" OC 2x4	13	0	U-factor	0.102	per Software/ Other	0.102	1095
South Exterior Wall	Nonresidential/Relocatable 1 CZ: New	IA4 Tables	Exterior wall	Wood 1/2" gyp 16" OC 2x4	13	0	U-factor	0.102	per IA4 per Software/ Other	0.102	337
East Exterior Wall	Nonresidential/Relocatable 1 CZ: New	IA4 Tables	Exterior wall	Wood 1/2" gyp 16" OC 2x4	13	0	U-factor	0.102	per IA4 per Software/ Other	0.102	831
North Exterior Wall	Nonresidential/Relocatable 1 CZ: New	IA4 Tables	Exterior wall	Wood 1/2" gyp 16" OC 2x4	13	0	U-factor	0.102	per IA4 per Software/ Other	0.102	214

Registration Number:

Registration Date/Time:

Registration Provider: Energysoft

CA Building Energy Efficiency Standards - 2019 Nonresidential Compliance

Report Version: 2019.1.009

Schema Version: rev 20200601

Report Generated: 2022-04-13 18:14:13

STATE OF CALIFORNIA

Envelope Component Approach

NRCC-ENVE

CERTIFICATE OF COMPLIANCE

Project Name:

GTS Office

Report Pages:

Pages 6 of 113

Project Address:

12881 166th Street

Date Prepared:

4/13/2023

CALIFORNIA ENERGY COMMISSION

NRCC-ENVE

H. WALL ASSEMBLY SCHEDULE

03	04	05	06	07	08	09	10	11	12	13	
Tag/Plan Detail ID	Occupancy & Status	How Design U-factor was determined	Location	Frame Material, Spacing & Depth	Cavity Insulation per Design	Continuous Insulation per Design	Thermal Performance Unit	Required Thermal Performance	U-factor per Design	Net Area ^a ft ²	
East Exterior Wall	Nonresidential/Relocatable 1 CZ- New	IAA Tables	Exterior wall	Wood 1/2" gyp 16" OC 2x4	13	0	U-factor	0.102	per IAA per Software/ Other	0.102	483

FOOTNOTES: If any individual assembly is non-compliant, assemblies may show compliance using an area-weighted calculation. Metal framed walls may not be combined with other wall types. Wood framed walls are combined with SIPs, spandrel & curtain, metal panel and straw bale wall types. The area-weighted compliance option is not available for alterations demonstrating compliance with R-values in Table 141.0-C.

*If "R-value" is shown in cell 10 as the Thermal Performance Unit, the R-value shown here is for cavity insulation per §141.0(b)(1B).

^a Wall area minus any fenestration area

Area-Weighted Average U-factor Compliance Calculation for Wood Framed/ SIPs/ Spandrel/ Curtain/ Metal Panel/ Straw Bale Wall Types

01	02	03	04	05
Wall Type	Total Area of Wall Type (ft ²)	Area-weighted U-factor for Wall Type		Compliance Results Using Area-Weighted Calculation Option
		Required	Designed	
Framed	3834	0.102	0.102	
Total for all Wall Types:	3834	0.102	0.102	COMPLIES

I. FLOOR ASSEMBLY SCHEDULE

This section does not apply to this project.

Registration Number:

Registration Date/Time:

Registration Provider: Energysift

CA Building Energy Efficiency Standards - 2019 Nonresidential Compliance

Report Number: 2019-1-003

Report Generated: 2022-04-13 18:14:13

Schema Version: rev 20200601

STATE OF CALIFORNIA

Envelope Component Approach

NRCC-ENV-E

CALIFORNIA ENERGY CODE

CERTIFICATE OF COMPLIANCE

OTS Office Report Page:

NRCC-ENV-E

Project Name:

(Pages 7 of 11)

Project Address:

12851 166th Street

Date Prepared:

4/13/2022

I. EXTERIOR DOOR SCHEDULE

This table demonstrates compliance with prescriptive exterior door requirements in [§40.3\(a\)2](#) for new construction or additions. Doors which are being replaced (alterations) do not need to be documented in this table because there are no Title 24, Part 6 requirements that apply. Exterior doors separate conditioned space from unconditioned space or from ambient air. Doors that are more than 25% glass in area are considered Glazed Doors and should be documented on Table K with fenestration per Table B.

01	02	03	04	05	06	07
Tag/Plan Detail ID	Name/Description	Occupancy Type	Door Type	Door Insulation	Maximum Allowed U-factor	U-factor per Design
	Metal Door	Nonresidential/ Relocatable 1 CZ	Swinging	Any other wood door	0.7	per IAA 0.7

K. FENESTRATION AND GLAZED DOOR SCHEDULE

This table demonstrates compliance with prescriptive fenestration requirements in [§40.3\(a\)5](#) for new constructions or additions, or [§40.1\(b\)2A](#) for alterations. Exterior doors that are more than one-half glass in area are considered Glazed Doors and should be documented on this table for fenestration.

Indicate fenestration types included in the project: ☒ Vertical (alterations) ☒ Vertical (new) ☐ Skylights ☐ Glazed Doors (new only)

¹ FOOTNOTES: Fenestration types indicated above as "new only" do not have Title 24, Part 6 requirements for alterations. New construction and additions do have requirements and should be checked above and compliance demonstrated within this table.

Vertical Fenestration and Glazed Doors: Total Building & West Facing Area (New Construction & Additions Only)

01	02	03	04	05	
Elevation Item Tag/Description	Orientation (Azimuth) ¹	Gross Exterior Wall Area ²	Display Perimeter Length ³	Vertical Fenestration Area per Design ³	
North	North Facing	428	0	0	
East	East Facing	3444	0	732	
South	South Facing	770	0	48	
West	West Facing	0	0	0	
06	Maximum Allowed Vertical Fenestration (ft ²)- All Orientations	1845.6	07	Total Vertical Fenestration (ft ²) per design- All Orientations	780
08	Maximum Allowed Vertical Fenestration (ft ²)- West Facing	0	09	Total Vertical Fenestration (ft ²) per design- West Facing	0

¹ FOOTNOTES: Orientation between 226 deg and 315 deg are considered "West Facing". A diagram has been provided in the Nonresidential Compliance Manual for visual reference.

² Do not include demising walls per [§40.3\(a\)5](#).

³ Includes glazed door fenestration area.

Registration Number:

Registration Date/Time:

Registration Provider: Energysoft

CA Building Energy Efficiency Standards - 2019 Nonresidential Compliance

Report Version: 2019.0.20

Schema Version: rev. 20200601

Report Generated: 2022-04-13 08:14:13

DATE OF CALIFORNIA

ENVELOPE COMPONENT APPROACH

NRCC-ENVE

CALIFORNIA ENERGY COMMISSION

NRCC-ENVA

Page # of 41

4/13/2022

Project Name:

075 Office

Report Page:

Project Address:

12881 166th Street

Date Prepared:

K. FENESTRATION AND GLAZED DOOR SCHEDULE

Vertical Fenestration And Glazed Doors - U-factor, Solar Heat Gain Coefficient (RSHGC/ SHGC), Visible Transmittance (VT)

01	<input checked="" type="checkbox"/>	Calculate Area-Weighted Average U-factor for Vertical Fenestration and Glazed Doors ¹
02	<input checked="" type="checkbox"/>	Calculate Area-Weighted Average R[SHGC] for Vertical Fenestration and Glazed Doors ¹
03	<input checked="" type="checkbox"/>	Calculate Area-Weighted Average VT for Vertical Fenestration and Glazed Doors ¹

Vertical Fenestration And Glazed Doors - U-factor, Solar Heat Gain Coefficient (RSHGC/ SHGC), Visible Transmittance (VT)

Tag/Plan Detail ID	Fenestration Type	Occupancy & Status	R[SHGC] Compliance Method	VT Compliance Method	Calculation Method for Performance Values per Design ¹	10 Product Performance Unit	11 Required Product Performance	12 Product Performance per Design	13 Area ft ²
Window	Fixed window	Nonresidential/ Relocatable 1 CZ : New			NFRC Certified	U-factor (max)	0.36	0.36	270
					<input type="checkbox"/> Overhang used for RSHGC	(RSHGC) (max)	0.25	0.25	
Door	Fixed window	Nonresidential/ Relocatable 1 CZ : New			NFRC Certified	U-factor (max)	0.42	0.36	54
					<input type="checkbox"/> Overhang used for RSHGC	(RSHGC) (max)	0.25	0.25	
Window	Fixed window	Nonresidential/ Relocatable 1 CZ : New			NFRC Certified	U-factor (max)	0.36	0.36	48
					<input type="checkbox"/> Overhang used for RSHGC	(RSHGC) (max)	0.25	0.25	
Window	Fixed window	Nonresidential/ Relocatable 1 CZ : New			NFRC Certified	U-factor (max)	0.36	0.36	264
					<input type="checkbox"/> Overhang used for RSHGC	(RSHGC) (max)	0.25	0.25	
Window	Fixed window	Nonresidential/ Relocatable 1 CZ : New			NFRC Certified	U-factor (max)	0.36	0.36	144
					<input type="checkbox"/> Overhang used for RSHGC	(RSHGC) (max)	0.25	0.25	

Footnotes:

If any individual fenestration product is non-compliant, products may show compliance using an area-weighted calculation. Chromogenic glazing is not included in area-weighted calculations. Area-weighted calculation shown in separate area-weighted table below.

Registration Number:

Registration Date/Time:

Registration Provider: EnergoSoft

CA Building Energy Efficiency Standards - 2019 Nonresidential Compliance

Report Version: 2019.01.09

Report Generated: 2022-04-13 18:14:13

Schema Version: rev 20200601

STATE OF CALIFORNIA		CALIFORNIA ENERGY COMMISSION	
Envelope Component Approach		NRCC-ENV-4	
NRCC-ENV-4			
CERTIFICATE OF COMPLIANCE			
Project Name:	GTS Office	Report Pages:	NRCC-ENV-4 (Pages 9 of 11)
Project Address:	12881 166th Street	Date Prepared:	4/17/2023

K. FENESTRATION AND GLAZED DOOR SCHEDULE

The NAE Default Calculation can only be used for buildings with less than 2000² of site glazing. If the project has greater than 2000², the only options for determining fenestration values are NFRC Certification or the Default Tables in 110.6.

** Overhangs must extend past the left and right window the same distance as the depth of the overhang or greater to show an effect on the RSHGC. If an overhang does not meet this requirement, the effect of the overhang will be ignored.*

**Projecting includes casement and awning windows.*

Area-Weighted Average U-factor, SHGC, VT Compliance Calculation for Vertical Fenestration And Glazed Doors				
01	02	03	04	05
Product Performance Unit	Total Area of Fenestration (ft ²)	Area-weighted Calculation for Fenestration		Compliance Results Using Area-Weighted Calculation Option
		Required	Designed	
U-Factor	780	0.36	0.36	COMPLIES
(R)SHGC	780	0.25	0.25	COMPLIES
VT	780	0.42	0.42	COMPLIES

L. DAYLIGHT IN LARGE OPENED SPACES

This section does not apply to this project.


M. DECLARATION OF REQUIRED CERTIFICATES OF INSTALLATION

Selections have been made based on information provided in this document. If any selection have been changed by the permit applicant, an explanation should be included in Table E

Additional Remarks. These documents must be provided to the building inspector during construction and can be found online at https://www.energy.ca.gov/titles24-201/Standards/2019_compliance_documents/Nonresidential_Documents/NRCC/

Form/Title	Field Inspector	
	Pass	Fail
NRCC-ENV-01-E - Must be submitted for all buildings	<input type="checkbox"/>	<input type="checkbox"/>

Registration Number:	Registration Date/Time:	Registration Provider: Energysoft
CA Building Energy Efficiency Standards - 2019 Nonresidential Compliance	Report Version: 2019.1.1.003 Schema Version: rev 20200601	Report Generated: 2022-04-13 18:14:13

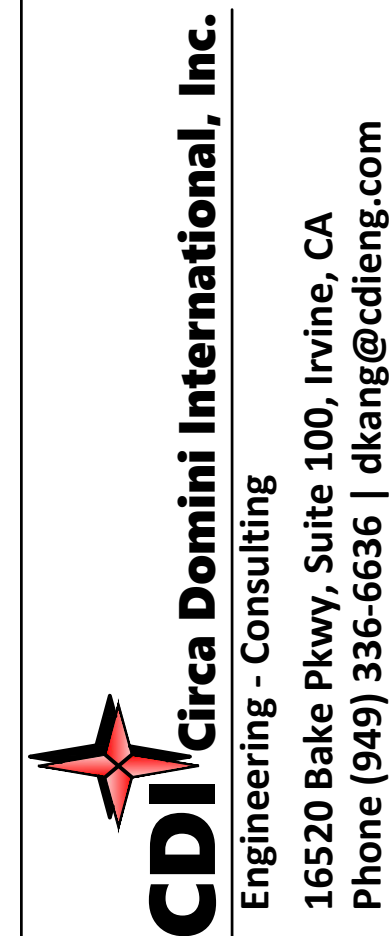


GST OFFICE

12881 166TH STREET,
CERRITOS, CA 90703

REVISION	1	PLAN CHECK REV. 06/30/2022
	2	REVISION 10-14-22
	3	
	4	
	5	
	6	
	7	
DATE:	03/22/2022	
SCALE:		

MECHANICAL
TITLE 24

TM00

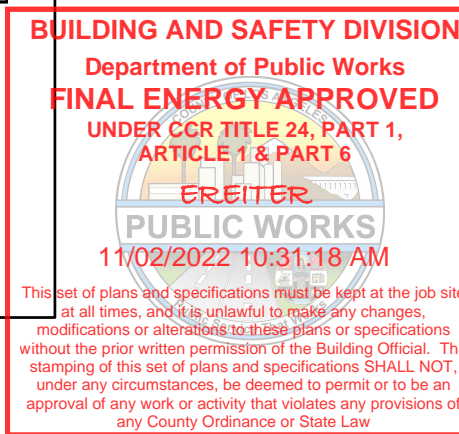

STATE OF CALIFORNIA
Envelope Component Approach
NRC-ENV-E
CALIFORNIA ENERGY COMMISSION

CERTIFICATE OF COMPLIANCE
Project Name: GTS Office
Project Address: 12881 166th Street
Report Page: (Page 16 of 11)
Date Prepared: 4/13/2022

N. DECLARATION OF REQUIRED CERTIFICATES OF ACCEPTANCE
Selections have been made based on information provided in previous tables of this document. If any selection needs to be changed, form user must provide an explanation in Table E. Additional Remarks. These documents must be provided to the building inspector during construction and can be found online at https://www.energy.ca.gov/title24/2019_standards/2019_compliance_documents/nonresidential_documents/NRCA/. Individuals who perform the field testing and verification work, and provide the information required for completion of the fenestration Certificate of Acceptance documentation are not required to be licensed professionals. However, the person who signs the Certificate of Acceptance document to certify compliance with the acceptance requirements shall be licensed as specified in Standards Section 10-103(a)(4) and M27.1.1.
Form/Title: Systems/Spaces To Be Field Verified: Field Inspector: Pass: Fail:
NRCA-ENV-02-F must be submitted for all new, added or altered fenestration.

Registration Number: CA Building Energy Efficiency Standards - 2019 Nonresidential Compliance
Registration Date/Time: Report Version: 2019.1.003
Registration Provider: Energysoft
Schema Version: rev 20200601
Report Generated: 2022-04-13 18:14:13

STATE OF CALIFORNIA
Envelope Component Approach
NRC-ENV-E
CALIFORNIA ENERGY COMMISSION

CERTIFICATE OF COMPLIANCE
Project Name: GTS Office
Project Address: 12881 166th Street
Report Page: (Page 11 of 11)
Date Prepared: 4/13/2022

DOCUMENTATION AUTHOR'S DECLARATION STATEMENT
I certify that this Certificate of Compliance documentation is accurate and complete.
Documentation Author Name: David Kang
Company: CDI
Address: 16520 Bake Parkway, Suite 100
City/State/Zip: Irvine CA 92618
Signature Date: 2022-04-13
CDV/MS Certification Identification (if applicable): M37036
Phone:
Responsible Person's DECLARATION STATEMENT
I certify the following under penalty of perjury, under the laws of the State of California:
1. The information provided on this Certificate of Compliance is true and correct.
2. I am eligible under Division 3 of the Business and Professions Code to accept responsibility for the building design or system design identified on this Certificate of Compliance (responsible designer).
3. The energy features and performance specifications, materials, components, and manufactured devices for the building design or system design identified on this Certificate of Compliance conform to the requirements of Title 24, Part 1 and Part 6 of the California Code of Regulations.
4. The building design features or system design features identified on this Certificate of Compliance are consistent with the information provided on other applicable compliance documents, worksheets, calculations, plans and specifications submitted to the enforcement agency for approval with this building permit application.
5. I will ensure that a completed signed copy of this Certificate of Compliance shall be made available with the building permit(s) issued for the building, and made available to the enforcement agency for all applicable inspections. I understand that a completed signed copy of this Certificate of Compliance is required to be included with the documentation the builder provides to the building owner at occupancy.
Responsible Designer Name: David Kang
Company: CDI
Address: 16520 Bake Parkway, Suite 100
City/State/Zip: Irvine CA 92618
Date Signed: 2022-04-13
License: M37036
Phone:
Registration Number: CA Building Energy Efficiency Standards - 2019 Nonresidential Compliance
Registration Date/Time: Report Version: 2019.1.003
Registration Provider: Energysoft
Schema Version: rev 20200601
Report Generated: 2022-04-13 18:14:13

STATE OF CALIFORNIA
Mechanical Systems
NRC-MCH-E
CALIFORNIA ENERGY COMMISSION

CERTIFICATE OF COMPLIANCE
Project Name: GTS Office
Project Address: 12881 166th Street
Report Page: (Page 1 of 15)
Date Prepared: 4/13/2022

A. GENERAL INFORMATION
01 Project Location (city): Cerritos
02 Climate Zone: 8
03 Total Conditioned Floor Area: 8650
04 Total Unconditioned Floor Area: 0
05 Occupancy Types Within Project: 1
06 # of Stories (Habitable Above Grade):
Office (B): Retail (M): Non-refrigerated Warehouse (S):
Hotel/ Motel Guest Rooms (R-1): School (E): Healthcare Facility (I):
High-Rise Residential (R-2/R-3): Relocatable Class Bldg (E): Other (write in): See Table J

B. PROJECT SCOPE
This table includes mechanical systems or components that are within the scope of the permit application and are demonstrating compliance using the prescriptive path outlined in §140.4, or §141.0(b)(2) for alterations.
01 Air System(s): Heating Air System, Cooling Air System, Mechanical Controls, Mechanical Controls (existing to remain, altered or new)
02 Wet System Components: Water Economizer, System Piping, Cooling Towers, Chillers, Boilers
03 Dry System Components: Air Economizer, Electric Resistance Heat, Fan Systems, Ductwork (existing to remain, altered or new), Ventilation, Zonal Systems/ Terminal Boxes

Registration Number: CA Building Energy Efficiency Standards - 2019 Nonresidential Compliance
Registration Date/Time: Report Version: 2019.1.003
Registration Provider: Energysoft
Schema Version: rev 20200601
Report Generated: 2022-04-13 18:14:13

STATE OF CALIFORNIA
Mechanical Systems
NRC-MCH-E
CALIFORNIA ENERGY COMMISSION

CERTIFICATE OF COMPLIANCE
Project Name: GTS Office
Project Address: 12881 166th Street
Report Page: (Page 2 of 15)
Date Prepared: 4/13/2022

C. COMPLIANCE RESULTS
Table C will indicate if the project data input into the compliance document is compliant with mechanical requirements. This table is not editable by the user. If this table says "DOES NOT COMPLY" or "COMPLIES with Exceptional Conditions" refer to Table D., or the table indicated as not compliant for guidance.
01 System Summary §110.1, §110.2, §140.4
02 AND
03 Pumps §140.4(k)
04 AND
05 Fans/Economizers §140.4(c), §140.4(e)
06 AND
07 System Controls §110.2, §120.2, §140.4(f)
08 AND
09 Ventilation §120.1
10 AND
11 Terminal Box Controls §140.4(d)
12 AND
13 Distribution §120.3, §140.4(i)
14 AND
15 Cooling Towers §110.2(b)(2)
16 Compliance Results
(See Table F): (See Table G): (See Table H): (See Table I): (See Table J): (See Table K): (See Table L): (See Table M):
Yes AND Yes AND Yes AND Yes AND Yes AND Yes AND Yes AND COMPLIES
Mandatory Measures Compliance (See Table Q for details)

D. EXCEPTIONAL CONDITIONS
This table is auto-filled with uneditable comments because of selections made or data entered in tables throughout the form.

E. ADDITIONAL REMARKS
This table includes remarks made by the permit applicant to the Authority Having Jurisdiction.

Registration Number: CA Building Energy Efficiency Standards - 2019 Nonresidential Compliance
Registration Date/Time: Report Version: 2019.1.003
Registration Provider: Energysoft
Schema Version: rev 20200601
Report Generated: 2022-04-13 18:14:13

STATE OF CALIFORNIA
Mechanical Systems
NRC-MCH-E
CALIFORNIA ENERGY COMMISSION

CERTIFICATE OF COMPLIANCE
Project Name: GTS Office
Project Address: 12881 166th Street
Report Page: (Page 3 of 15)
Date Prepared: 4/13/2022

F. HVAC SYSTEM SUMMARY (DRY & WET SYSTEMS)
This table is used to demonstrate compliance for mechanical equipment with mandatory requirements found in §110.1 and §110.2(a), and prescriptive requirements found in §140.4(a), §140.4(b), and §140.4(k) or §141.0(b)(2) for alterations.
Dry System Equipment Sizing (includes air conditioners, condensers, heat pumps, VRF, furnaces and unit heaters)
01 Equipment Category per Tables 110.2 / 02 Equipment Type per Tables 110.2 / Title 20
03 Smallest Size Available §140.4(a)
04 Heating Output^{1,3} (kBtu/h)
05 Cooling Output^{1,3} (kBtu/h)
06 Load Calculations^{3,4}
07 Per Design (kBtu/h)
08 Rated (kBtu/h)
09 Supp. Heating Output (kBtu/h)
10 Sensible Per Design (kBtu/h)
11 Rated (kBtu/h)
12 Total Sensible Cooling Load (kBtu/h)
HVAC System 1: Unitary Heat Pumps, Air-cooled, pkg (3 phase), NA: Load Controls, 35.49, 47.5, 0, 33.39, 34.3, 14.18, 38.42
HVAC System 2: Unitary Heat Pumps, Air-cooled, pkg (3 phase), NA: Load Controls, 68.73, 92, 0, 71.7, 70, 17.52, 78.82
HVAC System 3: Unitary Heat Pumps, Air-cooled, pkg (3 phase), NA: Load Controls, 79.19, 106, 0, 80.54, 80.5, 44.42, 95.03
HVAC System 4: Unitary Heat Pumps, Air-cooled, pkg (3 phase), NA: Load Controls, 35.49, 47.5, 0, 33.15, 34.3, 25.4, 38.1
FOOTNOTES: Equipment shall be the smallest size, within the available options of the desired equipment line, necessary to meet the design heating and cooling loads of the building per §140.4(a). Healthcare facilities are exempted.
It is common practice to show rated output capacity on the equipment schedule. Sensible cooling output comes from specification sheet tables.
If equipment is heating only, leave cooling output and load blank. If equipment is cooling only, leave heating output and load blank.
Authority Having Jurisdiction may ask for load calculations used for compliance per §140.4(b).

Registration Number: CA Building Energy Efficiency Standards - 2019 Nonresidential Compliance
Registration Date/Time: Report Version: 2019.1.003
Registration Provider: Energysoft
Schema Version: rev 20200601
Report Generated: 2022-04-13 18:14:13

STATE OF CALIFORNIA
Mechanical Systems
NRC-MCH-E
CALIFORNIA ENERGY COMMISSION

CERTIFICATE OF COMPLIANCE
Project Name: GTS Office
Project Address: 12881 166th Street
Report Page: (Page 4 of 15)
Date Prepared: 4/13/2022

F. HVAC SYSTEM SUMMARY (DRY & WET SYSTEMS)
Dry System Equipment Efficiency (other than Package Terminal Air Conditioners (PTAC) and Package Terminal Heat Pumps (PTHP))
01 Name or Item Tag
02 Size Category (Btu/h)
03 Heating Mode: Rating Condition (°F), Efficiency Unit
04 Minimum Efficiency Required per Tables 110.2 / Title 20
05 Design Efficiency
06 Efficiency Unit
07 Minimum Efficiency Required per Tables 110.2 / Title 20
08 Design Efficiency
HVAC System 1: <65,000, HSPF, 7.7, 8.2, SEER, 13.0, 14.3
HVAC System 2: >=65,000 and <135,000, COP, 3.3, 3.4, EER, 12.2, 11
HVAC System 3: >=65,000 and <135,000, COP, 3.3, 3, EER, 12.2, 12.2
HVAC System 4: <65,000, HSPF, 7.7, 8.2, SEER, 13.0, 14.3
G. PUMPS
This section does not apply to this project.
H. FAN SYSTEMS & AIR ECONOMIZERS
This table is used to demonstrate compliance with prescriptive requirements found in §140.4(c), §140.4(e), and §140.4(m) for fan systems. Fan systems serving only process loads are exempt from these requirements and do not need to be included in Table H.
System Name: HVAC System 1, Economizer¹, NA: <=54 kBtu/h cooling, Economizer Controls: Designed per §140.4(e) and (m), System Fan Type: Constant Volume
01 Fan Name or Item Tag
02 Fan Function
03 Qty
04 Maximum Design Supply Airflow (CFM)
05 HP Unit²
06 Design HP
07 Fan Power Pressure Drop Adjustment - Table 140.4-B
08 Device
09 Design Airflow through Device (CFM)
SF, Supply, 1, 1600, BHP, 1, Maximum System Fan Power (BHP):
Total System Design Supply Airflow (CFM): 1600, Total System Design (BHP): 1

Registration Number: CA Building Energy Efficiency Standards - 2019 Nonresidential Compliance
Registration Date/Time: Report Version: 2019.1.003
Registration Provider: Energysoft
Schema Version: rev 20200601
Report Generated: 2022-04-13 18:14:13

STATE OF CALIFORNIA
Mechanical Systems
NRC-MCH-E
CALIFORNIA ENERGY COMMISSION

CERTIFICATE OF COMPLIANCE
Project Name: GTS Office
Project Address: 12881 166th Street
Report Page: (Page 5 of 15)
Date Prepared: 4/13/2022

H. FAN SYSTEMS & AIR ECONOMIZERS
System Name: HVAC System 2, Economizer¹, Fixed Temperature, Economizer Controls: Designed per §140.4(a) and (m), System Fan Type: Constant Volume
01 Fan Name or Item Tag
02 Fan Function
03 Qty
04 Maximum Design Supply Airflow (CFM)
05 HP Unit²
06 Design HP
07 Fan Power Pressure Drop Adjustment - Table 140.4-B
08 Device
09 Design Airflow through Device (CFM)
SF, Supply, 1, 3400, BHP, 2, Maximum System Fan Power (BHP):
Total System Design Supply Airflow (CFM): 3400, Total System Design (BHP): 2
System Name: HVAC System 3, Economizer¹, Fixed Temperature, Economizer Controls: Designed per §140.4(a) and (m), System Fan Type: Constant Volume
01 Fan Name or Item Tag
02 Fan Function
03 Qty
04 Maximum Design Supply Airflow (CFM)
05 HP Unit²
06 Design HP
07 Fan Power Pressure Drop Adjustment - Table 140.4-B
08 Device
09 Design Airflow through Device (CFM)
SF, Supply, 1, 4000, BHP, 2.75, Maximum System Fan Power (BHP):
Total System Design Supply Airflow (CFM): 4000, Total System Design (BHP): 2.75
System Name: HVAC System 4, Economizer¹, NA: <=54 kBtu/h cooling, Economizer Controls: Designed per §140.4(a) and (m), System Fan Type: Constant Volume
01 Fan Name or Item Tag
02 Fan Function
03 Qty
04 Maximum Design Supply Airflow (CFM)
05 HP Unit²
06 Design HP
07 Fan Power Pressure Drop Adjustment - Table 140.4-B
08 Device
09 Design Airflow through Device (CFM)
SF, Supply, 1, 1600, BHP, 1, Maximum System Fan Power (BHP):
Total System Design Supply Airflow (CFM): 1600, Total System Design (BHP): 1
FOOTNOTES: Computer room economizers must meet requirements of §140.9(a) and will be documented on the NRC-PRC-E document.
The unit used for HP must be consistent for all fans within a system.

Registration Number: CA Building Energy Efficiency Standards - 2019 Nonresidential Compliance
Registration Date/Time: Report Version: 2019.1.003
Registration Provider: Energysoft
Schema Version: rev 20200601
Report Generated: 2022-04-13 18:14:13

STATE OF CALIFORNIA
Mechanical Systems
NRC-MCH-E
CALIFORNIA ENERGY COMMISSION

CERTIFICATE OF COMPLIANCE
Project Name: GTS Office
Project Address: 12881 166th Street
Report Page: (Page 6 of 15)
Date Prepared: 4/13/2022

I. SYSTEM CONTROLS
This table is used to demonstrate compliance with mandatory controls in §110.2 and §120.2 and prescriptive controls in §140.4(f) and (n) or requirements in §141.0(b)(2) for altered space conditioning systems.
01 System Name
02 System Zoning
03 Conditioned Floor Area Being Served (ft²)
04 Thermostats §110.2(b) & (c)¹, §120.2(a)(iv), §141.0(b)(2)E
05 Shut-Off Controls §120.2(a)
06 Isolation Zone Controls §120.2(a)
07 Demand Response §110.12 and §120.2(b)
08 Air Temp. Reset §140.4(f)
09 Window Interlocks per §140.4(n)
HVAC System 1: Single zone, <= 25,000 ft², Setback, Auto Timer Switch, NA: Serves < 25k ft², NA: Serves temp. sensitive process, NA: Would increase energy use, NA: No operable windows
HVAC System 2: Single zone, <= 25,000 ft², Setback, Auto Timer Switch, NA: Serves < 25k ft², NA: Serves temp. sensitive process, NA: Would increase energy use, NA: No operable windows
HVAC System 3: Single zone, <= 25,000 ft², Setback, Auto Timer Switch, NA: Serves < 25k ft², NA: Serves temp. sensitive process, NA: Would increase energy use, NA: No operable windows
HVAC System 4: Single zone, <= 25,000 ft², Setback, Auto Timer Switch, NA: Serves < 25k ft², NA: Serves temp. sensitive process, NA: Would increase energy use, NA: No operable windows
FOOTNOTES: Gravity gas wall heaters, gravity floor heaters, gravity room heaters, non-central electric heaters, fireplaces or decorative gas appliances, wood stoves are not required to have setback thermostats.
Notes: Controls with a * require a note in the space below explaining how compliance is achieved. Ex: system 1: SA Temp Reset: Exempt because zones compliant with §140.4(d); EXCEPTION 1 to §140.4(f)


Registration Number: CA Building Energy Efficiency Standards - 2019 Nonresidential Compliance
Registration Date/Time: Report Version: 2019.1.003
Registration Provider: Energysoft
Schema Version: rev 20200601
Report Generated: 2022-04-13 18:14:13

STATE OF CALIFORNIA
Mechanical Systems
NRC-MCH-E
CALIFORNIA ENERGY COMMISSION

CERTIFICATE OF COMPLIANCE
Project Name: GTS Office
Project Address: 12881 166th Street
Report Page: (Page 7 of 15)
Date Prepared: 4/13/2022

J. VENTILATION AND INDOOR AIR QUALITY
This table is used to demonstrate compliance with mandatory ventilation requirements in §120.1 and §120.2(a)(3), for all nonresidential, high-rise residential and hotel/motel occupancies. For alterations, only ventilation systems being altered within the scope of the permit application need to be documented in this table. In lieu of this table, the required outdoor ventilation rates and airflow may be shown on the plans or the calculations can be presented in a spreadsheet.
01 Check the box if the project is showing ventilation calculations on the plans, or attaching the calculations instead of completing this table.
02 Check this box if the project included Nonresidential or Hotel/Motel spaces
03 Check this box if the project included new or altered high-rise residential dwelling units.
04 Check the box if the project is using natural ventilation in any nonresidential or hotel/motel spaces to meet required ventilation rates per §120.1(c)(2).
Nonresidential and Hotel/ Motel Ventilation Systems
System Name: HVAC System 1, System Design OA CFM Airflow⁴: 168, System Design Transfer Air CFM: 0, Air Filtration per §120.1(c) and §141.0(b)(2)²: Provided per §120.1(c) (NR and Hotel/Motel)
08 Mechanical Ventilation Required per §120.1(c)(3)¹: Exh. Vent per §120.1(c)(4)
Space Name or Item Tag: Occupancy Type⁴, Conditioned Floor Area (ft²), # of Shower heads/ toilets, # of people, Required Min OA CFM, Required Min CFM, Provided per Design CFM, DCV or Sensor Controls per §120.1(d)(3), §120.1(d)(5), and §120.1(e)(3)⁵
Break Room: Break room, 1120, 560, 0, 0, DCV, Provided per §120.1(d)(4), NA: Not required space type
17 Total System Required Min OA CFM: 560, 18, Ventilation for this System Completes? Yes
System Name: HVAC System 2, System Design OA CFM Airflow⁴: 300, System Design Transfer Air CFM: 0, Air Filtration per §120.1(c) and §141.0(b)(2)²: Provided per §120.1(c) (NR and Hotel/Motel)
08 Occupancy Type⁴, Conditioned Floor Area (ft²), # of Shower heads/ toilets, # of people, Required Min OA CFM, Required Min CFM, Provided per Design CFM

Registration Number: CA Building Energy Efficiency Standards - 2019 Nonresidential Compliance
Registration Date/Time: Report Version: 2019.1.003
Registration Provider: Energysoft
Schema Version: rev 20200601
Report Generated: 2022-04-13 18:14:13

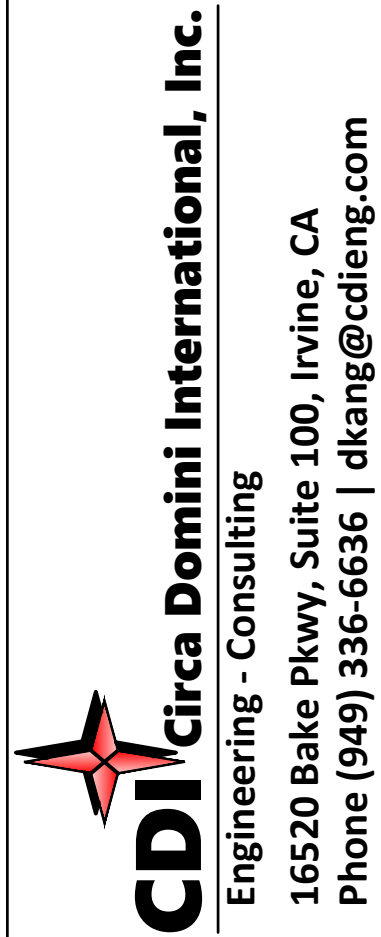

GST OFFICE

12881 166TH STREET,
CERRITOS, CA 90703

REVISION
PLAN CHECK REV. 06/30/2022
REVISION 10-14-22
DATE: 03/22/2022
SCALE:

SHEET TITLE:
MECHANICAL
TITLE 24

TM01

STATE OF CALIFORNIA
Mechanical Systems
NRC-MCH-E
CERTIFICATE OF COMPLIANCE
Project Name: GTS Office Report Page: NRCC-MCH-E (Page 8 of 15)
Project Address: 12881 166th Street Date Prepared: 4/13/2022

J. VENTILATION AND INDOOR AIR QUALITY

Space Name or Item Tag	Occupancy Type ⁴	Conditioned Floor Area (ft ²)	# of Shower heads/ toilets	# of people ⁵	Required Min OA CFM	Exh. Vent per §120.1(c)(4)	DCV or Sensor Controls per §120.1(d)(3), §120.1(d)(5), and §120.1(e)(3) ⁶
Warehouse	Warehouse	3205			480.8	0	DCV NA: Not required per §120.1(d)(3) Occ Sensor NA: Not required space type
17	Total System Required Min OA CFM				481	18	Ventilation for this System Complies? Yes
04		05		06		07	
System Name	HVAC System 3	System Design OA CFM Airflow ⁷	638	System Design Transfer Air CFM	0	Air Filtration per §120.1(c) and §141.0(b)(2) ² Provided per §120.1(c) (NR and Hotel/Motel)	
08		09		10		11	
Space Name or Item Tag	Occupancy Type ⁴	Conditioned Floor Area (ft ²)	# of Shower heads/ toilets	# of people ⁵	Required Min OA CFM	Exh. Vent per §120.1(c)(4)	DCV or Sensor Controls per §120.1(d)(3), §120.1(d)(5), and §120.1(e)(3) ⁶
Deck	All others	3405			510.8	0	DCV NA: Not required per §120.1(d)(3) Occ Sensor NA: Not required space type
17	Total System Required Min OA CFM				511	18	Ventilation for this System Complies? Yes
04		05		06		07	
System Name	HVAC System 4	System Design OA CFM Airflow ⁷	368	System Design Transfer Air CFM	0	Air Filtration per §120.1(c) and §141.0(b)(2) ² Provided per §120.1(c) (NR and Hotel/Motel)	
08		09		10		11	

Registration Number: CA Building Energy Efficiency Standards - 2019 Nonresidential Compliance
Registration Date/Time: Report Version: 2019.1.003
Registration Provider: Energysoft Schema Version: rev 20200601
Report Generated: 2022-04-13 18:14:13

STATE OF CALIFORNIA
Mechanical Systems
NRC-MCH-E
CERTIFICATE OF COMPLIANCE
Project Name: GTS Office Report Page: NRCC-MCH-E (Page 11 of 15)
Project Address: 12881 166th Street Date Prepared: 4/13/2022

L. DISTRIBUTION (DUCTWORK AND PIPING)

The answers to the questions below apply to the following duct systems: HVAC System 3 Duct leakage testing triggered for these systems? Yes

11	No	The scope of the project includes only duct systems serving healthcare facilities
12	Yes	Duct system provides conditioned air to an occupiable space for a constant volume, single zone, space-conditioning system.
13	Yes	The space conditioning system serves less than 5,000 ft ² of conditioned floor area.
14	Yes	The combined surface area of the ducts in the following locations is more than 25% of the total surface area of the entire duct system: <input type="checkbox"/> Outdoors <input type="checkbox"/> In a space directly under a roof that has a U-factor greater than the u-factor of the ceiling, or if the roof does not meet the requirements of §140.3(a)(18) or if the roof has fixed vents or openings to the outside/ unconditioned spaces <input type="checkbox"/> In an unconditioned crawl space <input type="checkbox"/> In other unconditioned spaces
15		The scope of the project includes extending an existing duct system, which is constructed, insulated or sealed with asbestos.
16		The scope of the project includes an existing duct system that is documented to have been previously sealed as confirmed through field verification and diagnostic testing in accordance with procedures in the Reference Nonresidential Appendix NA2.
17	Yes	Duct system shall be sealed in accordance with the California Mechanical Code

The answers to the questions below apply to the following duct systems: HVAC System 4 Duct leakage testing triggered for these systems? Yes

11	No	The scope of the project includes only duct systems serving healthcare facilities
12	Yes	Duct system provides conditioned air to an occupiable space for a constant volume, single zone, space-conditioning system.
13	Yes	The space conditioning system serves less than 5,000 ft ² of conditioned floor area.
14	Yes	The combined surface area of the ducts in the following locations is more than 25% of the total surface area of the entire duct system: <input type="checkbox"/> Outdoors <input type="checkbox"/> In a space directly under a roof that has a U-factor greater than the u-factor of the ceiling, or if the roof does not meet the requirements of §140.3(a)(18) or if the roof has fixed vents or openings to the outside/ unconditioned spaces <input type="checkbox"/> In an unconditioned crawl space <input type="checkbox"/> In other unconditioned spaces
15		The scope of the project includes extending an existing duct system, which is constructed, insulated or sealed with asbestos.
16		The scope of the project includes an existing duct system that is documented to have been previously sealed as confirmed through field verification and diagnostic testing in accordance with procedures in the Reference Nonresidential Appendix NA2.
17	Yes	Duct system shall be sealed in accordance with the California Mechanical Code

Registration Number: CA Building Energy Efficiency Standards - 2019 Nonresidential Compliance
Registration Date/Time: Report Version: 2019.1.003
Registration Provider: Energysoft Schema Version: rev 20200601
Report Generated: 2022-04-13 18:14:13

STATE OF CALIFORNIA
Mechanical Systems
NRC-MCH-E
CERTIFICATE OF COMPLIANCE
Project Name: GTS Office Report Page: NRCC-MCH-E (Page 14 of 15)
Project Address: 12881 166th Street Date Prepared: 4/13/2022

O. DECLARATION OF REQUIRED CERTIFICATES OF ACCEPTANCE

Selections have been made based on information provided in previous tables of this document. If any selection needs to be changed, please explain why in Table E Additional Remarks. These documents must be provided to the building inspector during construction and can be found online at https://www.energy.ca.gov/title24/2019standards/2019_compliance_documents/Nonresidential_Documents/NRCA/

Form/Title	Systems/Spaces To Be Field Verified	Field Inspector	
		Pass	Fail
NRCA-MCH-12-A FDD for Packaged Direct Expansion Units	Trane WSC102H(3.4,WJ)*(G,K,NJA); Trane WSC120H(3.4,WJ)*(G,K,N,PJA);	<input type="checkbox"/>	<input type="checkbox"/>

P. DECLARATION OF REQUIRED CERTIFICATES OF VERIFICATION

There are no NRCV forms required for this project.

Q. MANDATORY MEASURES DOCUMENTATION LOCATION

This table is used to indicate where mandatory measures are documented in the plan set or construction documentation.

01	02
Compliance with Mandatory Measures documented through MCH Mandatory Measures Note Block	Yes M-Sheets

Registration Number: CA Building Energy Efficiency Standards - 2019 Nonresidential Compliance
Registration Date/Time: Report Version: 2019.1.003
Registration Provider: Energysoft Schema Version: rev 20200601
Report Generated: 2022-04-13 18:14:13

STATE OF CALIFORNIA
Mechanical Systems
NRC-MCH-E
CERTIFICATE OF COMPLIANCE
Project Name: GTS Office Report Page: NRCC-MCH-E (Page 9 of 15)
Project Address: 12881 166th Street Date Prepared: 4/13/2022

J. VENTILATION AND INDOOR AIR QUALITY

Space Name or Item Tag	Occupancy Type ⁴	Conditioned Floor Area (ft ²)	# of Shower heads/ toilets	# of people ⁵	Required Min OA CFM	Exh. Vent per §120.1(c)(4)	DCV or Sensor Controls per §120.1(d)(3), §120.1(d)(5), and §120.1(e)(3) ⁶
Gym	Health club/aerobics	920			138	0	DCV NA: Not required per §120.1(d)(3) Occ Sensor NA: Not required space type
17	Total System Required Min OA CFM				138	18	Ventilation for this System Complies? Yes

¹ FOOTNOTES: System CFM should include both mechanical and natural ventilation for the zone/system
² Air filtration requirements apply to the following three system types per §120.1(c)(4): space conditioning systems utilizing ducts to supply air to occupiable space; supply-only ventilation systems providing outside air to occupiable space; supply side of balanced ventilation systems including heat recovery and energy recovery ventilation systems providing outside air to occupiable space.
³ Uniform Mechanical Code may have more stringent ventilation requirements; the most stringent code requirement takes precedence.
⁴ See Standards Tables 120.1-A and 120.1-B.
⁵ For lecture halls with fixed seating, the expected number of occupants shall be determined in accordance with the California Building Code.
⁶ §120.1(e)(3) requires systems serving rooms that are required by §130.1(j) to have lighting occupancy sensing controls to also have occupancy sensing zone controls for ventilation. Examples of spaces which require lighting occupancy sensors include offices >250ft² or smaller, multipurpose rooms less than 1,000 ft², classrooms, conference rooms, restrooms, aisles and open areas in warehouses, library book stack aisles, corridors, stairwells, parking garages, and loading and unloading zones, unless excepted by §130.1(j).

K. TERMINAL BOX CONTROLS

This section does not apply to this project.

L. DISTRIBUTION (DUCTWORK AND PIPING)

This table is used to show compliance with mandatory pipe insulation requirements found in §120.3 and prescriptive requirements found in §140.4(f) for duct leakage testing.

Duct Leakage Sealing

Registration Number: CA Building Energy Efficiency Standards - 2019 Nonresidential Compliance
Registration Date/Time: Report Version: 2019.1.003
Registration Provider: Energysoft Schema Version: rev 20200601
Report Generated: 2022-04-13 18:14:13

STATE OF CALIFORNIA
Mechanical Systems
NRC-MCH-E
CERTIFICATE OF COMPLIANCE
Project Name: GTS Office Report Page: NRCC-MCH-E (Page 12 of 15)
Project Address: 12881 166th Street Date Prepared: 4/13/2022

M. COOLING TOWERS

This section does not apply to this project.

N. DECLARATION OF REQUIRED CERTIFICATES OF INSTALLATION

Selections have been made based on information provided in previous tables of this document. If any selection needs to be changed, please explain why in Table E Additional Remarks. These documents must be provided to the building inspector during construction and can be found online at https://www.energy.ca.gov/title24/2019standards/2019_compliance_documents/Nonresidential_Documents/NRCI/

Form/Title	Field Inspector	
	Pass	Fail
NRCC-MCH-01-E - Must be submitted for all buildings	<input type="checkbox"/>	<input type="checkbox"/>


Registration Number: CA Building Energy Efficiency Standards - 2019 Nonresidential Compliance
Registration Date/Time: Report Version: 2019.1.003
Registration Provider: Energysoft Schema Version: rev 20200601
Report Generated: 2022-04-13 18:14:13

STATE OF CALIFORNIA
Mechanical Systems
NRC-MCH-E
CERTIFICATE OF COMPLIANCE
Project Name: GTS Office Report Page: NRCC-MCH-E (Page 15 of 15)
Project Address: 12881 166th Street Date Prepared: 4/13/2022

DOCUMENTATION AUTHOR'S DECLARATION STATEMENT

I certify that this Certificate of Compliance documentation is accurate and complete.

Documentation Author Name: David Kang
Company: CDI
Address: 16520 Bake Parkway, Suite 100
City/State/Zip: Irvine CA 92618

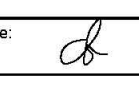
Documentation Author Signature: 
Signature Date: 2022-04-13
CEV/HERS Certification Identification (if applicable): M37036
Phone:

RESPONSIBLE PERSON'S DECLARATION STATEMENT

I certify the following under penalty of perjury, under the laws of the State of California:

- The information provided on this Certificate of Compliance is true and correct.
- I am eligible under Division 3 of the Business and Professions Code to accept responsibility for the building design or system design identified on this Certificate of Compliance (responsible designer).
- The energy features and performance specifications, materials, components, and manufactured devices for the building design or system design identified on this Certificate of Compliance conform to the requirements of Title 24, Part 1 and Part 6 of the California Code of Regulations.
- The building design features or system design features identified on this Certificate of Compliance are consistent with the information provided on other applicable compliance documents, worksheets, calculations, plans and specifications submitted to the enforcement agency for approval with this building permit application.
- I will ensure that a completed signed copy of this Certificate of Compliance shall be made available with the building permit(s) issued for the building, and made available to the enforcement agency for all applicable inspections. I understand that a completed signed copy of this Certificate of Compliance is required to be included with the documentation the builder provides to the building owner at occupancy.

Responsible Designer Name: David Kang
Company: CDI
Address: 16520 Bake Parkway, Suite 100
City/State/Zip: Irvine CA 92618

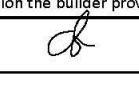Responsible Designer Signature: 
Date Signed: 2022-04-13
License: M37036
Phone:

Registration Number: CA Building Energy Efficiency Standards - 2019 Nonresidential Compliance
Registration Date/Time: Report Version: 2019.1.003
Registration Provider: Energysoft Schema Version: rev 20200601
Report Generated: 2022-04-13 18:14:13

STATE OF CALIFORNIA
Mechanical Systems
NRC-MCH-E
CERTIFICATE OF COMPLIANCE
Project Name: GTS Office Report Page: NRCC-MCH-E (Page 10 of 15)
Project Address: 12881 166th Street Date Prepared: 4/13/2022

L. DISTRIBUTION (DUCTWORK AND PIPING)

The answers to the questions below apply to the following duct systems: HVAC System 1 Duct leakage testing triggered for these systems? Yes

11	No	The scope of the project includes only duct systems serving healthcare facilities
12	Yes	Duct system provides conditioned air to an occupiable space for a constant volume, single zone, space-conditioning system.
13	Yes	The space conditioning system serves less than 5,000 ft ² of conditioned floor area.
14	Yes	The combined surface area of the ducts in the following locations is more than 25% of the total surface area of the entire duct system: <input type="checkbox"/> Outdoors <input type="checkbox"/> In a space directly under a roof that has a U-factor greater than the u-factor of the ceiling, or if the roof does not meet the requirements of §140.3(a)(18) or if the roof has fixed vents or openings to the outside/ unconditioned spaces <input type="checkbox"/> In an unconditioned crawl space <input type="checkbox"/> In other unconditioned spaces
15		The scope of the project includes extending an existing duct system, which is constructed, insulated or sealed with asbestos.
16		The scope of the project includes an existing duct system that is documented to have been previously sealed as confirmed through field verification and diagnostic testing in accordance with procedures in the Reference Nonresidential Appendix NA2.
17	Yes	Duct system shall be sealed in accordance with the California Mechanical Code

The answers to the questions below apply to the following duct systems: HVAC System 2 Duct leakage testing triggered for these systems? Yes

11	No	The scope of the project includes only duct systems serving healthcare facilities
12	Yes	Duct system provides conditioned air to an occupiable space for a constant volume, single zone, space-conditioning system.
13	Yes	The space conditioning system serves less than 5,000 ft ² of conditioned floor area.
14	Yes	The combined surface area of the ducts in the following locations is more than 25% of the total surface area of the entire duct system: <input type="checkbox"/> Outdoors <input type="checkbox"/> In a space directly under a roof that has a U-factor greater than the u-factor of the ceiling, or if the roof does not meet the requirements of §140.3(a)(18) or if the roof has fixed vents or openings to the outside/ unconditioned spaces <input type="checkbox"/> In an unconditioned crawl space <input type="checkbox"/> In other unconditioned spaces
15		The scope of the project includes extending an existing duct system, which is constructed, insulated or sealed with asbestos.
16		The scope of the project includes an existing duct system that is documented to have been previously sealed as confirmed through field verification and diagnostic testing in accordance with procedures in the Reference Nonresidential Appendix NA2.
17	Yes	Duct system shall be sealed in accordance with the California Mechanical Code

Registration Number: CA Building Energy Efficiency Standards - 2019 Nonresidential Compliance
Registration Date/Time: Report Version: 2019.1.003
Registration Provider: Energysoft Schema Version: rev 20200601
Report Generated: 2022-04-13 18:14:13

O. DECLARATION OF REQUIRED CERTIFICATES OF ACCEPTANCE

Selections have been made based on information provided in previous tables of this document. If any selection needs to be changed, please explain why in Table E Additional Remarks. These documents must be provided to the building inspector during construction and can be found online at https://www.energy.ca.gov/title24/2019standards/2019_compliance_documents/Nonresidential_Documents/NRCA/

Form/Title	Systems/Spaces To Be Field Verified	Field Inspector	
		Pass	Fail
NRCA-MCH-02-A - Outdoor Air must be submitted for all newly installed HVAC units. Note: MCH-02-A can be performed in conjunction with MCH-07-A Supply Fan VFD Acceptance (if applicable) since testing activities overlap.	Trane WSC048H4*(B,E,GJA); Trane WSC102H(3.4,WJ)*(G,K,NJA); Trane WSC120H(3.4,WJ)*(G,K,N,PJA); Trane WSC048H4*(B,E,GJA);	<input type="checkbox"/>	<input type="checkbox"/>
NRCA-MCH-03-A - Constant Volume Single Zone HVAC NOTE: This form does not automatically move to "Yes". If Constant Volume Single Zone HVAC Systems are included in the scope, permit applicant should move this form to "Yes".	Trane WSC048H4*(B,E,GJA); Trane WSC102H(3.4,WJ)*(G,K,NJA); Trane WSC120H(3.4,WJ)*(G,K,N,PJA); Trane WSC048H4*(B,E,GJA);	<input type="checkbox"/>	<input type="checkbox"/>
NRCA-MCH-05-A - Air Economizer Controls	Trane WSC048H4*(B,E,GJA); Trane WSC102H(3.4,WJ)*(G,K,NJA); Trane WSC120H(3.4,WJ)*(G,K,N,PJA); Trane WSC048H4*(B,E,GJA);	<input type="checkbox"/>	<input type="checkbox"/>
NRCA-MCH-06-A Demand Control Ventilation Systems must be submitted for all systems required to employ demand controlled ventilation (refer to §120.1(c)) can vary outside ventilation flow rates based on maintaining interior carbon dioxide (CO2) concentration setpoints.	Trane WSC048H4*(B,E,GJA); Trane WSC102H(3.4,WJ)*(G,K,NJA); Trane WSC120H(3.4,WJ)*(G,K,N,PJA); Trane WSC048H4*(B,E,GJA);	<input type="checkbox"/>	<input type="checkbox"/>
NRCA-MCH-11-A Automatic Demand Shed Controls	Trane WSC048H4*(B,E,GJA); Trane WSC102H(3.4,WJ)*(G,K,NJA); Trane WSC120H(3.4,WJ)*(G,K,N,PJA); Trane WSC048H4*(B,E,GJA);	<input type="checkbox"/>	<input type="checkbox"/>

Registration Number: CA Building Energy Efficiency Standards - 2019 Nonresidential Compliance
Registration Date/Time: Report Version: 2019.1.003
Registration Provider: Energysoft Schema Version: rev 20200601
Report Generated: 2022-04-13 18:14:13



DOOR GENERAL NOTES

1. EXIT DOORS SHALL BE CAPABLE OF OPENING WITHOUT THE USE OF A KEY OR ANY SPECIAL KNOWLEDGE OR EFFORT. BUILDING CODE 1008.1.9.
2. DOOR HARDWARE: HAND-ACTIVATED DOOR OPENING HARDWARE SHALL BE CENTERED BETWEEN 34" & 44" ABOVE THE FLOOR.
3. ALL DOORS SHALL BE FULLY ACCESSIBLE INCLUDING LEVER HANDLES
4. MAXIMUM EFFORT TO OPERATE DOORS SHALL NOT EXCEED 5 POUNDS. WHEN FIRE DOORS ARE REQUIRED, THE MAXIMUM EFFORT TO OPERATE THE DOOR MAY BE INCREASED TO THE MINIMUM ALLOWABLE BY THE APPROPRIATE ADMINISTRATIVE AUTHORITY, NOT EXCEED 15 POUNDS. (11B-402.2.9)
5. THE BOTTOM 10" OF ALL DOORS & GATES TO HAVE A SMOOTH UNINTERRUPTED SURFACE TO ALLOW THE DOOR TO BE OPENED BY A WHEELCHAIR FOOTREST WITHOUT CREATING A TRAP OR HAZARDOUS CONDITION (11B-402.2.10)
6. DOOR THRESHOLD NOT TO EXCEED 3/4" WITH BEVELED SLOPE NOT MORE THAN 2:1 FOR THE UPPER 3/4". (11-B303.3) SEE DETAIL.
7. ALL WOOD DOORS TO BE SOLID CORE.
8. ALL DOORS & FRAMES TO BE PAINTED.
9. C.C. TO PROVIDE SHOP DRAWINGS FOR HARDWARE GROUPS.
10. LOCK PREVENTING OPERATION OF DOOR SHALL NOT BE INSTALLED ON EXIT DOORS, U.N.O ON THE DOOR SCHEDULE
11. ALL EXIT DOORS SHALL COMPLY WITH SECTION 1008.1
 - A. CLEAR WIDTH OF EACH DOOR OPENING SHALL BE MIN. 32" OR PER SECT. 1005.1 WHICHEVER IS GREATER.
 - B. MINIMUM DOOR HEIGHT OF 6'-8" TYPICAL
 - C. SHALL BE CAPABLE OF OPENING 90 DEGREES
 - D. THE MAXIMUM WIDTH OF A SWINGING DOOR LEAF SHALL BE 48" NOMINAL.
 - E. EXIT DOOR SHALL BE SIDE-HINGED SWINGING TYPE

1. G.C. TO FURNISH & INSTALL FALCON CYLINDER IN ALL PERIMETER DOORS. ALL PERIMETER DOORS TO BE KEYED ALIKE. PROVIDE KEYWAY ON EXTERIOR FACE.
2. G.C. TO FURNISH & INSTALL FALCON CYLINDER IN ALL INTERIOR H.M. DOORS. ALL INTERIOR DOORS TO BE KEYED ALIKE. PROVIDE KEYWAY ON EXTERIOR FACE.
3. C.C. TO FURNISH & INSTALL PADLOCK WITH 4" SHANK FOR WALK-IN COOLER/FREEZER DOORS. PADLOCK TO BE KEYED ALIKE WITH INTERIOR DOORS. INTERIOR ALUMINUM TENANT IMPROVEMENT UNDER SEPARATE PERMIT.
4. ALL HOLLOW METAL DOOR FRAMES ARE TO BE WELDED.
5. G.C. TO FURNISH & INSTALL PANIC HARDWARE PER ALL APPLICABLE REGULATIONS & CODES HAVING JURISDICTION.
6. DOOR STOPS & BUMPERS TO BE INSTALLED BEHIND ALL DOORS.
7. EXTERIOR HARDWARE TO MATCH EXTERIOR STOREFRONT. USE SATIN ALUMINUM FOR CLEAR ANODIZED FINISH & US108 DARK BRONZE FOR BRONZE STOREFRONT. USE U28 SATIN ALUMINUM FOR ALL INTERIOR HARDWARE.
8. NO THRESHOLD REQUIRED AT INTERIOR VESTIBULE DOORS.

1. A FLOOR OR LANDING NOT MORE THAN 2' BELOW THE THRESHOLD IS REQUIRED ON EACH SIDE OF AN EXIT DOOR TO PROVIDE SIGN WITH 1" HIGH LETTERS ON CONTRASTING BACKGROUND AT DOOR TRANSOM TO READ: "THIS DOOR TO REMAIN UNLOCKED WHEN BUILDING IS OCCUPIED"
2. EXIT DOORS SHALL BE OPERABLE FROM THE INSIDE WITHOUT THE USE OF A KEY OR ANY SPECIFIC KNOWLEDGE
3. ALARM LOCK & PANIC HARDWARE PER ELECTRICAL DRAWINGS
4. PROVIDE PILE WEATHERSTRIPPING AT HEAD, JAMB & SILL
5. FRAMES SHALL BE EITHER ALUMINUM OR HOLLOW METAL AS INDICATED
6. ALL DOORS SHALL BE 1 3/4" IN THICKNESS
7. EXTERIOR DOORS SHALL HAVE WEATHERSTRIPPING AT THE HEAD & JAMB, & A THRESHOLD AT THE SILL
8. ALLOW 2" FROM EDGE OF DOOR FRAME TO FINISH OF ADJACENT WALL FOR HARDWARE CLEARANCE
9. DOORS SHALL SWING TO A FULL OPEN POSITION, WHEN OPENING FORCE NOT TO EXCEED 5 POUNDS FOR EXTERIOR & INTERIOR DOORS & 15 POUNDS FOR FIRE DOORS IS APPLIED AT RIGHT ANGLES TO HINGED DOORS & AT THE CENTER PLANE OF SLIDING OR FOLDING DOORS. COMPENSATING DEVICES OR AUTOMATIC DOOR OPERATORS MAY BE UTILIZED TO MEET THE ABOVE STANDARDS. CBC SECTION 11B-404.2
11. ALL DOOR HARDWARE SHALL BE LEVER TYPE, PUSH TYPE OR PANIC TYPE.

ITEM 24/ADA REQUIREMENTS

PER CBC CHAPTER 11B: HANDLES, PULLS & OTHER OPERATING DEVICES ON ACCESSIBLE DOORS SHALL HAVE A SHAPE THAT IS EASY TO GRASP WITH ONE HAND & DOES NOT REQUIRE TIGHT GRIPPING, TIGHT PINCHING OR TWISTING OF THE WRIST TO OPERATE. LEVER-OPERATED MECHANISMS, PUSH-TYPE MECHANISMS, & U-SHAPED HANDLES ARE ACCEPTABLE DESIGNS, WHEN SLIDING DOORS ARE FULLY OPEN, OPERATING HARDWARE SHALL BE EXPOSED & VISIBLE FROM BOTH SIDES. HARDWARE REQUIRED FOR ACCESSIBLE DOOR PASSAGE SHALL BE MOUNTED NO LOWER THAN 34" & NO HIGHER THAN 44" ABOVE THE FINISH FLOOR.

ROOM	ROOM	BASE	FLOOR	CEILING	WALL	REMARKS
1	ENTRANCE					
2	DINING					
3	KITCHEN					
4	PATIO					

The diagrams illustrate the correct placement of the 'PER SCHEDULE' label for three types of doors:

- A ENTRANCE STOREFRONT:** A double door with two panels. The label is placed vertically on the left side of the left panel, centered vertically. A 10" dimension line indicates the height of the label area.
- B STOREFRONT:** A single door with one panel. The label is placed vertically on the left side of the panel, centered vertically. A 10" dimension line indicates the height of the label area.
- C HOLLOW METAL:** A single door with a solid panel. The label is placed vertically on the left side of the panel, centered vertically. A 10" dimension line indicates the height of the label area.

The diagrams illustrate three different door and window configurations:

- D SOLID STEEL WOOD:** A vertical door with a diagonal brace and a handle. Dimensions include "PER SCHEDULE" for width and height.
- E DOOR:** A vertical door with a diagonal brace and a handle. Dimensions include "PER SCHEDULE" for width and height, and specific measurements for the handle area: 6" (width), 2' 9" (height), and 8" (width).
- R METAL ROLL-UP:** A vertical door with a diagonal brace and a handle. Dimensions include "PER SCHEDULE" for width and height.

SCHEDULE

UP DOOR

$\frac{1}{2}$ " CEMENT PLASTER OVER METAL LATH OVER BUILDING PAPER
 2x4 FOAM TRIM OVER SCRATCH & BROWN COATS COVERED W/FIBER-GLASS MESH & COLOR COAT TO MATCH STUCCO. INSTALL PER MANUF'S SPEC.
 $\frac{1}{2}$ " GYPSUM BD. WITH METAL CORNER REINFORCEMENT
 HEADER. SEE STRUCTURAL PLAN
 J-MOLD-PAINT TO MATCH STUCCO
 GAL. MTL FLASHING W/HEMMED EDGE
 ANCHOR DOOR FRAME PER MANUF. SPEC. & COVER WITH TRIM PIECE
 METAL DOOR FRAME
 HOLLOW METAL DOOR PER DOOR SCHEDULE
 INTERIOR
 EXTERIOR

Diagram illustrating the cross-section of a storefront window installation, showing the interior and exterior views.

Labels and components:

- 7/8" CEMENT PLASTER OVER METAL LATH OVER BUILDING PAPER
- 5/8" GYPSUM BD. WITH METAL CORNER REINFORCEMENT
- HEADER JAMB PER STRUCTURAL
- SHIM AS REQUIRED
- J-MOLD-PAINT TO MATCH STUCCO
- GALV. METAL FLASHING TO WRAP CORNER
- CAULKING & BACKER ROD
- STOREFRONT WINDOW FRAME
- 1" INSULATED GLAZING, LOW-3 TEMPERED WHERE REQUIRED. SEE EXTERIOR WHERE REQUIRED. SEE EXTERIOR ELEVATIONS & T-24

Orientation: INTERIOR (left) and EXTERIOR (right).

Diagram illustrating the section view of the exterior metal door head, showing the interior and exterior elevations.

Labels and dimensions:

- INTERIOR
- EXTERIOR
- 10"
- 1" INSULATED GLAZING, LOW-3 TEMPERED WHERE REQUIRED. SEE EXTERIOR ELEVATIONS & T-24
- STOREFRONT DOOR
- $\frac{3}{4}$ " THRESHOLD
- SLOPE TO DRAIN PER C.B.C.
- FOUNDATION
- 1/2" EXPANSION JOINT
- BLDG FOUNDATION

	DOOR SILL	6
--	-----------	---

EXTERIOR DOOR THRESHOLD	8
-------------------------	---

THIS DRAWING & ALL INFORMATION THEREON IS THE PROPERTY OF ZBT GROUP. THE DRAWING & ANY COPIES THEREOF, PARTIAL OR COMPLETE, SHALL BE RETURN TO THE ZBT GROUP UPON DEMAND.

 **ZBT GROUP**
LAND DEVELOPMENT CONSULTANTS

